SYMBOL	ABBREV.	DESCRIPTION		SYMBOL & DESCRIPTION	SYMBOL	DESCRIPTION						ABBD	EVIATIONS	
			קו			SUPPLY/OUTSIDE AIR D	UCT UP (S/A OR O/A)	AF	AIRFOIL		DWDI		HF-X	HYDRONIC FILTER
	CW HW	COLD WATER HOT WATER				SUPPLY/OUTSIDE AIR R	OOF/FLOOR PENETRATION	AC-X	AIR COMPRESSOR AIR CONDITIONING			ELECTRIC BASEBOARD RADIATOR		INSIDE DIAMETER
	RHW		່ ຈົ້	ΥΥΥ 🗋 🔥		SUPPLY/OUTSIDE AIR DI RETURN AIR DUCT UP (F	· · · · · · · · · · · · · · · · · · ·	A/C ACCU-X	AIR COOLED CONDENSING UNIT		ERAD-X EFT-X	ELECTRIC FIN TUBE	IH-X	INTAKE HOOD
A — A —	A AV	AIR ACID VENT	11 12	2 13 14 15 16 17 18 19 20		RETURN AIR ROOF/FLOO	OR PENETRATION	AHU-X AIR PD	AIR HANDLING UNIT AIR PRESSURE DROP		ERH-X EUH-X	ELECTRIC RADIANT HEATER ELECTRIC UNIT HEATER	ISP	INTERNAL STATIC PRESSURE
	AW		-0-t			RETURN AIR DUCT DOW EXHAUST AIR DUCT UP	( )	AS-X ATU	AIR SEPARATOR AIR TERMINAL UNIT		EL/ELEV ERV-X	ELEVATION ENERGY RECOVERY VENTILATOR	KW KWH	KILOWATT KILOWATT HOUR
CD	CD CHR	CONDENSATE CHILLED WATER RETURN		2 23 24 25 <sup>1</sup> 26 27 28 29 30 1. SHUT-OFF VALVE		EXHAUST AIR ROOF/FLC	OOR PENETRATION	AMB	AMBIENT		EAT	ENTERING AIR TEMPERATURE	KES KEF-X	KITCHEN EQUIPMENT SUPPLIER
—— CHS ——	CHS	CHILLED WATER SUPPLY		2. PRESSURE REDUCING VALVE	S S	EXHAUST AIR DUCT DO ROUND DUCT SECTION	· · /	ANSI ASHRAE	AMERICAN NATIONAL STANDARDS I AMERICAN SOCIETY OF HEATING, R	REFRIGERATI		ENTERING WATER TEMPERATURE EQUIPMENT	KEF-X KH-X	KITCHEN EXHAUST FAN KITCHEN HOOD
CWR	CWR CWS	CONDENSER WATER RETURN CONDENSER WATER SUPPLY		<ol> <li>BALANCE VALVE</li> <li>CHECK VALVE</li> </ol>	•	ROUND DUCT ROOF/FLC	OOR PENETRATION	AMP	AND AIR CONDITIONING ENGINEERS	S	ECU-X EVAP	EVAPORATIVE CONDENSING UNIT EVAPORATOR	LAT	LEAVING AIR TEMPERATURE
—— DI ——	DI	DEIONIZED WATER		5. CONTROL VALVE		ROUND DUCT SECTION 1. WIDTH DIMENSION	DOWN	ANG A	ANGLE AREA		EXH EA	EXHAUST EXHAUST AIR	LWT LG	LEAVING WATER TEMPERATURE LENGTH
DS DWR	DS DWR	DOWNSPOUT (RAINWATER) DUAL WATER RETURN		6. GAS COCK 7. THERMOMETER		2. DEPTH DIMENSION		AD-X	AIR DOOR		EF-X	EXHAUST FAN	LTG	LIGHTING
— DWS —	DWS	DUAL WATER SUPPLY		8. PRESSURE GAUGE		DUCT RISE IN DIRECTIO		APPROX AUX	APPROXIMATE AUXILIARY		EH-X EXIST	EXHAUST HOOD EXISTING	LD-X LF	LINEAR DIFFUSER LINEAR FEET
FOR FOS	FOR FOS	FUEL OIL RETURN FUEL OIL SUPPLY		9. MANUAL AIR VENT 10. UNION		DUCT DROP IN DIRECTION	JN	ATM AVG	ATMOSPHERE AVERAGE		ET-X ESP	EXPANSION TANK EXTERNAL STATIC PRESSURE	LP LRA	LIQUID PROPANE LOCKED ROTOR AMPS
FOV	FOV	FUEL OIL VENT		11. STRAINER W/DRAIN VALVE	$\left  \frac{1}{2} \right _{3}^{2}$	2. WIDTH DIMENSION 3. DEPTH DIMENSION		BI	BACKWARD INCLINED		°F	DEGREE FAHRENHEIT	L-X LPC	LOUVER LOW PRESSURE CONDENSATE
— FSPR — — G —	FSPR G	FIRE SPRINKLER NATURAL GAS LINE (FIRM)		12. TOP CONNECTION TEE W/ELBOW 13. BOTTOM CONNECTION TEE W/ELBOW		TYPICAL DUCT TURN		BIBC BOD	BACKWARD INCLINED BACKWARD C BOTTOM OF DUCT	CURVED	FCU-X FPB-X	FAN COIL UNIT FAN POWERED BOX	LPS	LOW PRESSURE STEAM POUNDS
—— GI ——	GI	GREASE INTERCEPTOR		14. SIDE CONNECTION TEE	R W	R EQUAL TO W (MINIMUI	M)	BOJ	BOTTOM OF JOIST		FT	FEET		
HG HPR	HG HPR	HOT GAS HIGH PRESSURE STEAM RETURN		15. SHOCK ABSORBER 16. FLOW METER FITTING		TYPICAL DUCT TURN WI	ТН	B-X BHP	BOILER BREAK HORSE POWER		FPM FPS	FEET PER MINUTE FEET PER SECOND	MBH MFR	1000 BTU'S MANUFACTURER
— HPS —	HPS	HIGH PRESSURE STEAM SUPPLY		17. PIPE ANCHOR		TURN VANES		BTU BLDG	BRITISH THERMAL UNIT BUILDING		FT-X FF-X	FIN TUBE FINAL FILTER	MAX MCA	MAXIMUM MAXIMUM CIRCUIT AMPACITY
HWR   HWS	HWR HWS	HEATING WATER RETURN HEATING WATER SUPPLY		18. BALANCE VALVE W/FLOW METER FITTING 19. FLOW CONTROL VALVE		1. CONICAL TAKE-OFF		CUH-X	CABINET UNIT HEATER		FLT-X FLR	FLASH TANK FLOOR	MA MAU-X	MAKE-UP AIR MAKE-UP AIR UNIT
IG	IG	NATURAL GAS LINE (INTERRUPTIBLE)		20. PIPE CAP, PLUG OR CLEANOUT		2. BRANCH DUCT INTO S	SIDE OF MAIN DUCT	CLG	CEILING		FC-X	FAN COIL	MECH	MECHANICAL
LPG   LPR	LPG LPR	LIQUIFIED PETROLEUM GAS LOW PRESSURE STEAM RETURN		21. FLOAT AND THERMOSTATIC TRAP 22. PRESSURE AND TEMPERATURE TEST PORT		TYPICAL SQUARE TO RO	OUND TRANSITION	C TO C CL	CENTER TO CENTER CENTER LINE		FC FA	FORWARD CURVED FREE AREA / FIRE ALARM	MC MPC	MECHANICAL CONTRACTOR MEDIUM PRESSURE CONDENSATE
— LPS —	LPS	LOW PRESSURE STEAM SUPPLY		23. FLOW DIRECTION ARROW		FLEXIBLE DUCT CONNE		CENT CF-X	CENTRIFUGAL CHEMICAL FEED SYSTEM		FOT-X FLA	FUEL OIL TANK FULL LOAD AMPS	MPS MIN	MEDIUM PRESSURE STEAM MINIMUM
— LSPR — — MPR —	lspr Mpr	LAWN SPRINKLER MEDIUM PRESSURE STEAM RETURN		24. EXPANSION JOINT 25. FLEX CONNECTOR		1. MOTORIZED DAMPER		CHR CHS	CHILLED WATER RETURN CHILLED WATER SUPPLY		F-X	FURNACE	MISC MV-X	MISCELLANEOUS MIXING VALVE
— MPS —	MPS	MEDIUM PRESSURE STEAM SUPPLY NON POTABLE COLD WATER		26. PRESSURE AND TEMPERATURE RELIEF VALVE		2. FIRE DAMPER 3. SMOKE DAMPER		CH-X	CHILLER		GAL	GALLONS	MTD	MOUNTED
│ ─── NP· ─── │ ─── NP· · ───	NPCW NPHW	NON POTABLE COLD WATER NON POTABLE HOT WATER		27. THREE WAY CONTROL VALVE 28. CONTINUATION SYMBOL		1. BACKDRAFT DAMPER		CPVC CLR	CHLORINATED POLYVINYL CHLORID CLEAR	JE	GPM GALV	GALLONS PER MINUTE GALVANIZED	MTG	MOUNTING
— NP·· —	NPRHW	NON POTABLE RECIRCULATED HOT WATER		29. PIPE DOWN	₿ <b>₽(</b> ) 1. 2. § 3.	2. STATIC PRESSURE SE 3. FIRE/SMOKE DAMPER		CO CMPR	CLEANOUT COMPRESSOR		G GPR-X	GAS GAS PRESSURE REGULATOR	NOM NC	NOMINAL NORMALLY CLOSED / NOISE CRITERIA
0	0 ORD	OXYGEN OVERFLOW DRAIN		30. PIPE UP		1. REHEAT COIL		CRAC-X CP-X	COMPUTER ROOM AIR CONDITIONE CONDENSATE PUMP	R	GA GC	GAUGE GENERAL CONTRACTOR	NO N/A	NORMALLY OPEN / NUMBER NOT APPLICABLE
RL	RL	REFRIGERANT LIQUID REFRIGERANT SUCTION		SPLASH BLOCK	₹ <u>2€-</u> 3	2. SPLITTER DAMPER 3. MANUAL VOLUME DAM	MPER	CDU	CONDENSER UNIT		GEN	GENERATOR	NIC	NOT IN CONTRACT NEUTRAL AIR
	RS SCW	SOFT COLD WATER	•	CONNECTION TO EXISTING				CU-X CUHP-X	CONDENSING UNIT CONDENSING UNIT HEAT PUMP		GH-X G-X	GRAVITY HOOD GRILLE		
s	SHW	SOFT HOT WATER SOFT RECIRCULATED HOT WATER		POINT OF DISCONNECT		SUPPLY AIR DIFFUSER 1	ΓAG	CV CCC-X	CONSTANT VOLUME / CONTROL VAL CLOSED CIRCUIT COOLER (FLUID CO		HZ	HERTZ	OA OC	OUTSIDE AIR ON CENTER
— S·· —   — SD —	SRHW SD	STORM DRAIN	0	CO CLEANOUT WH WALL HYDRANT	G-X X"/X" CFM XXX	RETURN GRILLE TAG		CC-X CT-X	COOLING COIL COOLING TOWER	,	HD HE-X	HEAD HEAT EXCHANGER	ORD ORD	OVERFLOW STORM DRAIN PIPING OVERFLOW ROOF DRAIN
тw	TW	TEMPERED WATER VENT	-1) @	FD FLOOR DRAIN				CU FT	CUBIC FEET		HP-X HPWR	HEAT PUMP HEAT PUMP WATER RETURN	PTAC-X	PACKAGED TERMINAL A/C
V VAC	V VAC	VENT		FS FLOOR SINK		THERMOSTAT		CFM CU IN	CUBIC FEET PER MINUTE CUBIC INCH		HPWS	HEAT PUMP WATER SUPPLY	PTHP-X	PACKAGED TERMINAL HEAT PUMP
W	W	WASTE ABOVE GRADE	+	HB HOSE BIBB	$\square$	THERMOSTAT W/LOCKIN NIGHT THERMOSTAT	NG COVER	DEG	DEGREE		HTR HTG	HEATER HEATING	PPM PERP	PARTS PER MILLION PERPENDICULAR
— – W – — — W —	W	WASTE BELOW FLOOR WASTE BELOW GRADE	<	WCO WALL CLEANOUT	ΦA	RECESSED STAT (ASPIR	RATING)	DP DIA	DEPTH / DEEP DIAMETER		HC-X HVAC	HEATING COIL HEATING, VENTILATING AND AIR CONDITIONING	PH PLBG	PHASE PLUMBING
			o	FCO FLOOR CLEANOUT	l D S	HUMIDISTAT OCCUPIED-UNOCCUP. S	WITCH	D-X	DIFFUSER		HWR	HEATING WATER RETURN	PC PHVAC	PLUMBING CONTRACTOR
			<u> </u>	- DCO DOUBLE CLEANOUT	$\langle X \rangle$	KEYED NOTES		DX DISC	DIRECT EXPANSION DISCONNECT		HWS HGT	HEATING WATER SUPPLY HEIGHT		PLUMBING, HEATING, VENTILATION AND AIR CONDITIONING
				TD TRENCH DRAIN		KEYED DEMOLITION NO	TES	DWG DB	DRAWING DRY BULB (Temperature)		HDPE HP	HIGH DENSITY POLYETHYLENE HORSE POWER	PVC PDU-X	POLYVINYL CHLORIDE POOL DEHUMIDIFICATION UNIT
			$\odot$	RD ROOF DRAIN	$\square$	REVISION NOTE NUMBE	R	DDVAV DC-X	DUAL DUCT VARIABLE AIR VOLUME DUST COLLECTOR		HR H-X	HOUR HUMIDIFIER	PIV PWR	POST INDICATOR VALVE POWER
GENERAL NOTES:						PIPING G	ENERAL NOTES:			HVAC GE	NERAL NOTES			
	TWORK, AND	EQUIPMENT SHOWN HALFTONE IS EXISTING	14.	ALL CONTROL WIRE AND CONDUIT SHALL COMPL ELECTRIC CODE AND DIVISION 16 OF THE SPECIF		AL	) NOT RUN PIPING ABOVE ELI	.ECTRICAL F	ANELS OR IN CODE			- TWORK ABOVE ELECTRICAL PANELS OR IN CODE	18.	COORDINATE SCHEDULE OF SHUTDOWN FOR EXIST FOR INSTALLATION OF NEW HVAC SYSTEMS, WITH
TO REMAIN. NEW.	PIPING, DUCT	WORK AND EQUIPMENT SHOWN FULL-TONE IS	15.	CONCRETE HOUSEKEEPING PADS TO SUIT MECH.	IANICAL EQUIPMENT		EQUIRED CLEARANCE SPACE ITH ALL TRADES.	ES. COORDIN	ATE ALL ROUTING WORK		EQUIRED CLEAF	RANCE SPACES. COORDINATE ALL ROUTING WORK		REPRESENTATIVE PRIOR TO SHUT.
	CONTRACT	OR IS RESPONSIBLE FOR ANY CUTTING AND		SHALL BE SIZED AND INSTALLED BY THE MC. MINI THICKNESS SHALL BE 4". PAD SHALL EXTEND BEY	IMUM CONCRETE PA	ND	STALL PIPING TO HEAT PUMP					ALL COORDINATE LOCATION OF DUCTWORK IN	19.	LOCATE ALL MECHANICAL EQUIPMENT (HEAT PUMP UNITS. ETC.) FOR UNOBSTRUCTED ACCESS TO UNIT
PATCHING N	EEDED FOR N	IECHANICAL INSTALLATION. PATCHING MUST		A MINIMUM OF 4" ON EACH SIDE. IT SHALL BE THE	E RESPONSIBILITY O	F RE	EMOVAL OF THE HEAT PUMP.			C	EILING SPACE V	/ITH ALL TRADES PRIOR TO FABRICATION AND		CONTROLS AND VALVING, AS REQUIRED BY MANUF
MATCH EXIS	HNG.			THE MC TO COORDINATE SIZE AND LOCATION OF HOUSEKEEPING PADS.	CONCRETE	PL	JMP.			IN	STALLATION OF	DUCTWORK.		INSTALLATION AND OPERATION REQUIREMENTS AN
		QUIRED FOR ALL VALVES, TRAPS, DAMPERS, ) SURFACE CEILINGS. ACCESS PANELS SHALL	16.	WHEN MECHANICAL WORK (HVAC, SHEET METAL,	, FIRE PROTECTION,		ROVIDE VIBRATION ISOLATOR DNNECTED TO AND WITHIN 5	-		3. F0 SI	-	ICTWORK CONSTRUCTION, SEE DETAILS IN DRAWING	20.	CERTAIN ITEMS SUCH AS RISES AND DROPS IN DUC DOORS, VOLUME DAMPERS, ETC., ARE INDICATED C
	ED BY MC AN WITH ARCHIT	D INSTALLED BY THE MC. COORDINATE EXACT		ETC.) IS SUBCONTRACTED, IT SHALL BE THE MC' COORDINATE SUBCONTRACTORS AND THE ASSO			T BASE ELBOW SUPPORTS AN ECHANICAL EQUIPMENT ROO		SUPPORTS) THROUGHOUT	4 D	ICTWORK SHAI	L NOT BE FABRICATED UNTIL ALL COORDINATION		DOCUMENT DRAWINGS FOR CLARITY FOR A SPECIF REQUIREMENT AND SHALL NOT BE INTERPRETED A
	MATERIALS	AND EQUIPMENT AND PERFORM ALL LABOR		WHEN DISCREPANCIES ARISE PERTAINING TO WH PROVIDES A PARTICULAR ITEM OF THE MECHANIC	HICH CONTRACTOR				OF FACH DROP IN THE HEAT			BEEN RESOLVED.		THE REQUIREMENT FOR THESE ITEMS.
REQUIRED 1	O INSTALL CO	MPLETE AND OPERABLE MECHANICAL		WHICH CONTRACTOR PROVIDES FINAL CONNECT	TIONS FOR A	PL	JMP WATER PIPING SYSTEMS	S. ALL PIPIN	S SHALL GRADE TO LOW			INSTALLED DUCTWORK DURING CONSTRUCTION TO	21.	ALL MAKE-UP AIR UNITS SHALL OPERATE WITHOUT
REQUIRED E	-	ON THE DRAWINGS, AS SPECIFIED AND AS		PARTICULAR ITEM OF THE MECHANICAL CONTRAC BROUGHT TO THE ATTENTION OF THE MC, WHOS	- )		Dints. Provide Hose end D Sers and Low Points.	JINAIN VALVI	SAT THE DUITOW OF ALL		NIMIZE DIRT, DI JCT SYSTEM.	EBRIS, AND FOREIGN OBJECTS FROM ENTERING THE		CARRYOVER.
5. CONTRACT	DOCUMENT D	RAWINGS FOR MECHANICAL WORK (HVAC AND		FINAL.			ILESS OTHERWISE NOTED, A	ALL PIPING IS	OVERHEAD, TIGHT TO	6. Bl	RANCH DUCT SI	ZES ARE THE SAME AS DIFFUSER NECK SIZE, UNLESS	22.	COORDINATE DIFFUSER, REGISTER, AND GRILLE LC ARCHITECTURAL REFLECTED CEILING PLANS, LIGH
/	DIAGRAMMA AL ARRANGEI	TIC AND ARE INTENDED TO CONVEY SCOPE MENT ONLY.	17.	THE LOCATIONS OF ALL ITEMS SHOWN ON THE DI FOR IN THE SPECIFICATIONS THAT ARE NOT DEFI		-	NDERSIDE OF STRUCTURE OF EQUIRED.	R SLAB, WIT	H SPACE FOR INSULATION IF	N	DTED OTHERWI	SE.		CEILING ITEMS AND MAKE MINOR DUCT MODIFICATI
6. INSTALLALL	MECHANICAI	. EQUIPMENT AND APPURTENANCES IN		DIMENSIONS ARE APPROXIMATE ONLY. THE EXAC NECESSARY TO SECURE THE BEST CONDITIONS		BE 6. IN	STALL PIPING SO THAT ALL V	ALVES. STR	AINERS, UNIONS, TRAPS.	7. A	L DUCTWORK S	SHALL CLEAR DOORS AND WINDOWS.	23.	IN CORRIDORS WHERE CEILING DEVICES AND AIR D INDICATED BETWEEN THE SAME LIGHT FIXTURES, II
		JFACTURERS' RECOMMENDATIONS, AND APPLICABLE CODES AND REGULATIONS.		DETERMINED BY THE PROJECT SITE CONDITIONS APPROVAL OF THE ENGINEER BEFORE BEING INS			ANGES, AND OTHER APPURT	TENANCES F	EQUIRING ACCESS ARE			DIMENSIONS, AS SHOWN ON THE DRAWINGS, ARE DIMENSIONS AND DUCT SIZE SHALL BE INCREASED TO	h	DEVICES AT THE QUARTER POINTS BETWEEN THE S
	,	TION OF ALL MECHANICAL WORK WITH		SCALE DRAWINGS.	STALLED. DO NOT				VALVE REMAINS IN SERVICE		-	R DUCT LINING THICKNESS.		UNLESS OTHERWISE SHOWN, LOCATE ALL ROOM SI
ARCHITECT	JRAL, PLUMB	NG, STRUCTURAL, CIVIL, ELECTRICAL WORK,	18.	ALL MISCELLANEOUS STEEL REQUIRED TO ENSU		W	HEN EQUIPMENT OR PIPING (	-	-			SQUARE ELBOWS WITH DOUBLE RADIUS TURNING		(CENTERLINE) A.F.F. NOTIFY THE ENGINEER OF ANY THE ABOVE LOCATION CANNOT BE MAINTAINED OR
ETC.,SHOW	I ON OTHER (	CONTRACT DOCUMENT DRAWINGS.		INSTALLATION AND AS SHOWN IN DETAILS FOR PI AND EQUIPMENT (UNLESS OTHERWISE NOTED) S	-, ,		EMOVED.			V	ANES UNLESS C	THERWISE INDICATED.		QUESTION ON LOCATION.
		IPLETED BEFORE ANY MECHANICAL SULATION IS APPLIED.		AND INSTALLED BY THE MC.			L BALANCING VALVES AND B		/ALVES SHALL BE PROVIDED /I ADJUSTABLE STOPS		-	.E CONNECTIONS IN ALL DUCTWORK SYSTEMS N, AND EXHAUST) CONNECTED TO HEAT PUMPS, FANS,		SMOKE DETECTORS SHALL BE FURNISHED AND WIF MC SHALL BE RESPONSIBLE FOR MOUNTING THE SI
9 LOCATE ALL	TEMPERATU	RE. PRESSURE. AND FLOW MEASURING	19.	ALL EQUIPMENT, PIPING, DUCTWORK, ETC., SHAL DETAILED, SPECIFIED, AND REQUIRED TO PROVID		(	EMORY STOPS).					PMENT WHICH REQUIRES VIBRATION ISOLATION. CTIONS SHALL BE PROVIDED AT THE POINT OF		DUCTWORK AS SHOWN ON THE DRAWINGS AND IN A MANUFACTURER'S PRINTED INSTRUCTIONS.
DEVICES IN	ACCESSIBLE	OCATIONS WITH STRAIGHT SECTION OF PIPE DOWNSTREAM AS RECOMMENDED BY THE		INSTALLATION.		9. PF	ROVIDE CHAIN WHEEL OPERA DOMS MOUNTED GREATER TH					THE EQUIPMENT UNLESS OTHERWISE INDICATED.	26	MC TO MAKE CUTS IN FLOOR FOR PENETRATIONS C
		OD ACCURACY.	20.	ALL DUCTWORK, PIPING AND EQUIPMENT SUPPO			O" A.F.F.	HAN 7-0 A.I	I, GHAIN SHALL EXTEIND TO			ISE NOTED, ALL DUCTWORK IS OVERHEAD, TIGHT	20.	MECHANICAL DUCT PENETRATIONS TO BE IN SLAB
,	,	D BALANCING AGENCY SHALL BE A MEMBER		STRUCTURAL STEEL SHALL BE COORDINATED WI CONTRACTOR. ALL ATTACHMENTS TO STEEL BAR			L VALVES (EXCEPT CONTROL	,			SULATION IF RE	DE OF THE STRUCTURE, WITH SPACE FOR QUIRED.		OR DAMAGE CONCRETE JOIST STEMS.
		BALANCE COUNCIL (AABC) OR THE NATIONAL ING BUREAU (NEBB). TESTING, ADJUSTING,		JOIST GIRDERS SHALL BE AT PANEL POINTS. PRO MEETING MSS STANDARDS. WELDING TO STRUCT			JLL SIZE OF PIPE BEFORE REI QUIPMENT AND CONTROLS.	DUCING SIZ	E TO MAKE CONNECTIONS TO	12. R	JNS OF FLEXIBL	E DUCT SHALL NOT EXCEED 3-0" AND NOT FORM AN		
	ING SHALL B	E PERFORMED IN ACCORDANCE WITH THE		SHALL NOT BE PERMITTED. THE USE OF C-CLAMP PERMITTED.	PS SHALL NOT BE	11 UN	NIONS AND/OR FLANGES SHA	ALL BE INSTA	LLED AT EACH PIECE OF	A	NGLE GREATER	THAN 45°.		
-		EMS OF THE SAME TYPE OF EQUIPMENT ARE	04			EC	QUIPMENT, IN BYPASSES, AND	D IN LONG F	IPING RUNS (100 FEET OR			TS, INCLUDING DIVIDED DUCTS AND TRANSITIONS ICTIONS, SHALL BE PROVIDED AT NO ADDITIONAL		
	• • • • • • • • • • • • • • • • • • • •	EMS OF THE SAME TYPE OF EQUIPMENT ARE FOF ONE MANUFACTURER SHALL BE USED.	21.	MECHANICAL EQUIPMENT, DUCTWORK, AND PIPIN SUPPORTED FROM METAL DECK.	NG SHALL NUT BE		ORE) TO PERMIT DISASSEMBI				OUND OBSTRU	,		
	,	ING, AND PLACEMENT OF CONCRETE SHALL		ALL ROOF MOUNTED EQUIPMENT CURBS FOR EQ		) BY	STALL ALL PIPING WITHOUT F					DOORS IN DUCTWORK TO PROVIDE ACCESS FOR ALL		
		ND ACI 318. CONCRETE SHALL CONFORM TO DRK SHALL CONFORM TO ACI 318, PART		THE MC SHALL BE FURNISHED BY THE MC AND IN	ISTALLED BY THE MO	C. 13. AL	L PIPING SHALL CLEAR DOOF	RS AND WIN	DOWS.			RS, FIRE DAMPERS, SMOKE DAMPERS, VOLUME IFIERS, COILS, AND OTHER ITEMS LOCATED IN THE		
ENTITLED "C	ONSTRUCTIC	N REQUIREMENTS." COMPRESSIVE STRENGTH	23.	LOCATIONS AND SIZES OF ALL FLOOR, ROOF, AND SHALL BE COORDINATED WITH ALL OTHER TRADE		14. AL	L VALVES SHALL BE ADJUST	ED FOR SM	OOTH AND EASY OPERATION.		,	CH REQUIRE SERVICE AND/OR INSPECTION.		
CONCRETE	SHALL BE BET	WEEN 5 AND 7 PERCENT OF VOLUME. SLUMP 0 4 INCHES. CONCRETE SHALL BE CURED FOR	٩V	ALL OPENINGS IN FIRE WALLS DUE TO DUCTWOR			FSETS IN PIPING AROUND O		NS SHALL BE PROVIDED AT			DOORS IN DUCTWORK FOR OPERATION, D MAINTENANCE OF ALL FANS, VALVES, AND		
	R PLACEMEN		24.	ETC., SHALL BE FIRE STOPPED WITH A PRODUCT		,					ECHANICAL EQU	· · ·		
		IENT CONNECTIONS WITH MANUFACTURER'S		APPROVED EQUAL.		TC	PUMPS, CHILLERS, COOLING	G TOWERS,				ONS FOR DUCTWORK GAUGES, BRACING, HANGERS,		
		AND PROVIDE ALL DUCT AND PIPING FOR FINAL EQUIPMENT CONNECTIONS TO		REFER TO TYPICAL DETAILS FOR DUCTWORK, PIF INSTALLATION.	PING, AND EQUIPMEN		HICH REQUIRE VIBRATION IS EXIBLE CONNECTIONS SHALL			A				

- COORDINATE ALL EQUIPMENT CONNECTIONS WITH MANUFACTURER'S DRAWINGS COORDINATE AND PROVIDE ALL DUCT AND PIPING 13. TRANSITIONS REQUIRED FOR FINAL EQUIPMENT CONNECTIONS TO FURNISHED EQUIPMENT. FIELD VERIFY AND COORDINATE ALL DUCT AND PIPING DIMENSIONS BEFORE FABRICATION.

- 25. REFER TO TYPICAL DETAILS FOR DUCTWORK, PIPING, AND EQUIPMENT INSTALLATION.
- 26. ALL WORK SHALL COMPLY WITH LOCAL CODES, INTERNATIONAL BUILDING CODE, UNIFORM AND INTERNATIONAL MECHANICAL CODE, AND NFPA.

EQUIPMENT AS POSSIBLE. 17. PROVIDE LINE SIZE STRAINER UPSTREAM OF EACH AUTOMATIC VALVE. PROVIDE SHUTOFF VALVE ON EACH SIDE OF STRAINER. 17. PROVIDE VOLUME DAMPER IN ALL BRANCH TAKEOFFS CONNECTING TO DIFFUSERS OR REGISTERS.

PF-X PHC-X PD P-X PRV-X P-X PROP	PRE FILTER PREHEAT COIL PRESSURE DROP PLUMBING FIXTURE PRESSURE REDUCING VALVE PUMP PROPELLER
RECIRC R-X RHC-X RLFA RV-X REQ'D RA RD RF-X RPM RH RTU-X RM	RECIRCULATE REGISTER REHEAT COIL RELIEF AIR RELIEF VALVE REQUIRED RETURN AIR ROOF DRAIN RETURN FAN REVOLUTIONS PER MINUTE RELATIVE HUMIDITY ROOFTOP UNIT ROOM
SCHED SEN SIM SWSI SA-X SD SPEC(S) SQ STD SUCT SP SA SF-X	SCHEDULE SENSOR SIMILAR SINGLE WHEEL SINGLE INLET SOUND ATTENUATOR STORM DRAIN PIPING SPECIFICATIONS SQUARE STANDARD SUCTION STATIC PRESSURE SUPPLY AIR SUPPLY FAN
TEMP TD TU-X TUR T-STAT TK TONS TSP TYP	TEMPERATURE TEMPERATURE DIFFERENCE TERMINAL UNIT TERMINAL UNIT REHEAT THERMOSTAT THICK 12000 BTU TOTAL STATIC PRESSURE TYPICAL
UL UH-X UV-X UNO	UNDERWRITERS LABORATORY UNIT HEATER UNIT VENTILATOR UNLESS NOTED OTHERWISE
VAR VAV VFD-X VERT V VOL	VARIABLE VARIABLE AIR VOLUME VARIABLE FREQUENCY DRIVE VERTICAL VOLT VOLUME
WG WPD W WT WB	WATER GAUGE WATER PRESSURE DROP WATT / WIDTH WEIGHT WET BULB TEMPERATURE
YD	YARD

	DRAWING INDEX	
M0.0	SYMBOLS & ABBREVIATIONS	
MECH	ANICAL	
M1.0	LEVEL ONE MECHANICAL PLAN	
	LEVEL TWO MECHANICAL PLAN LEVEL THREE MECHANICAL PLAN	
M1.3	LEVEL FOUR MECHANICAL PLAN	
	LEVEL FIVE MECHANICAL PLAN ROOF MECHANICAL PLAN	
	ENLARGED MECHANICAL PLANS	
	MECHANICAL SCHEDULES & DETAILS	
M2.1	MECHANICAL DETAILS (CONT.)	
M3.0 M3.1	MECHANICAL SPECIFICATIONS (1 OF 4)	
M3.1 M3.2	MECHANICAL SPECIFICATIONS (2 OF 4) MECHANICAL SPECIFICATIONS (3 OF 4)	
M3.3	MECHANICAL SPECIFICATIONS (4 OF 4)	
	VRF PIPING DIAGRAM	
M4.1	VRF UNIT SPECIFICATIONS	
PLUM		
	UNDERFLOOR PLUMBING PLAN LEVEL ONE PLUMBING PLAN	
P1.2	LEVEL TWO PLUMBING PLAN	
	LEVEL THREE PLUMBING PLAN LEVEL FOUR PLUMBING PLAN	
	LEVEL FOUR PLOMBING PLAN	
	ENLARGED PLUMBING PLANS	
P2.0	PLUMBING RISERS	
P3.0	PLUMBING SCHEDULE AND DETAILS	
	CODE REQUIREMENTS	
2006 II	NTERNATIONAL MECHANICAL CODE	
	NTERNATIONAL ENERGY ERVATION CODE	
	NTERNATIONAL BUILDING CODE	
	IATIONAL FIRE GAS CODE NAL FIRE PROTECTION ASSOCIATION	
	NOTICE	
	DOCUMENT AND ANY INFORMATION AINED WITHIN THIS DOCUMENT MAY NOT	
	PRODUCED IN PART OR WHOLE WITHOUT	
	EN PERMISSION OF RDH ENGINEERING,	
· · ·	33-9009. UNAUTHORIZED COPYING, OSURE, OR CONSTRUCTION USE ARE	
PROH	BITED BY COPYRIGHT LAWS. ALL	
	RTS, PLANS, SPECIFICATIONS, FIELD	
	AND NOTES AND OTHER DOCUMENTS, DING ALL DOCUMENTS ON ELECTRONIC	
MEDIA	, PREPARED BY THE DESIGN	
	ESSIONAL AS INSTRUMENTS OF SERVICE . REMAIN THE PROPERTY OF THE DESIGN	
	ESSIONAL.	
		I

REXISTING HVAC SYSTEMS, S, WITH THE OWNER'S

AT PUMPS, MAKE-UP AIR S TO UNIT ACCESS PANELS, MANUFACTURER'S ENTS AND/OR BY CODE.

S IN DUCTWORK, ACCESS CATED ON THE CONTRACT SPECIFIC LOCATION RETED AS THE EXTENT OF

THOUT MOISTURE

RILLE LOCATIONS WITH NS, LIGHTING, AND OTHER DIFICATIONS TO SUIT.

AIR DIFFUSERS ARE URES, INSTALL BOTH N THE SAME FIXTURE.

ROOM SENSORS AT 4-0" R OF ANY ROOMS WHERE INED OR WHERE THERE IS A


AND WIRED BY THE EC. THE G THE SMOKE DETECTOR IN AND IN ACCORDANCE WITH

TIONS OF DUCTWORK. IN SLAB ONLY. DO NOT CUT

## SYMBOLS & ABBREVIATIONS





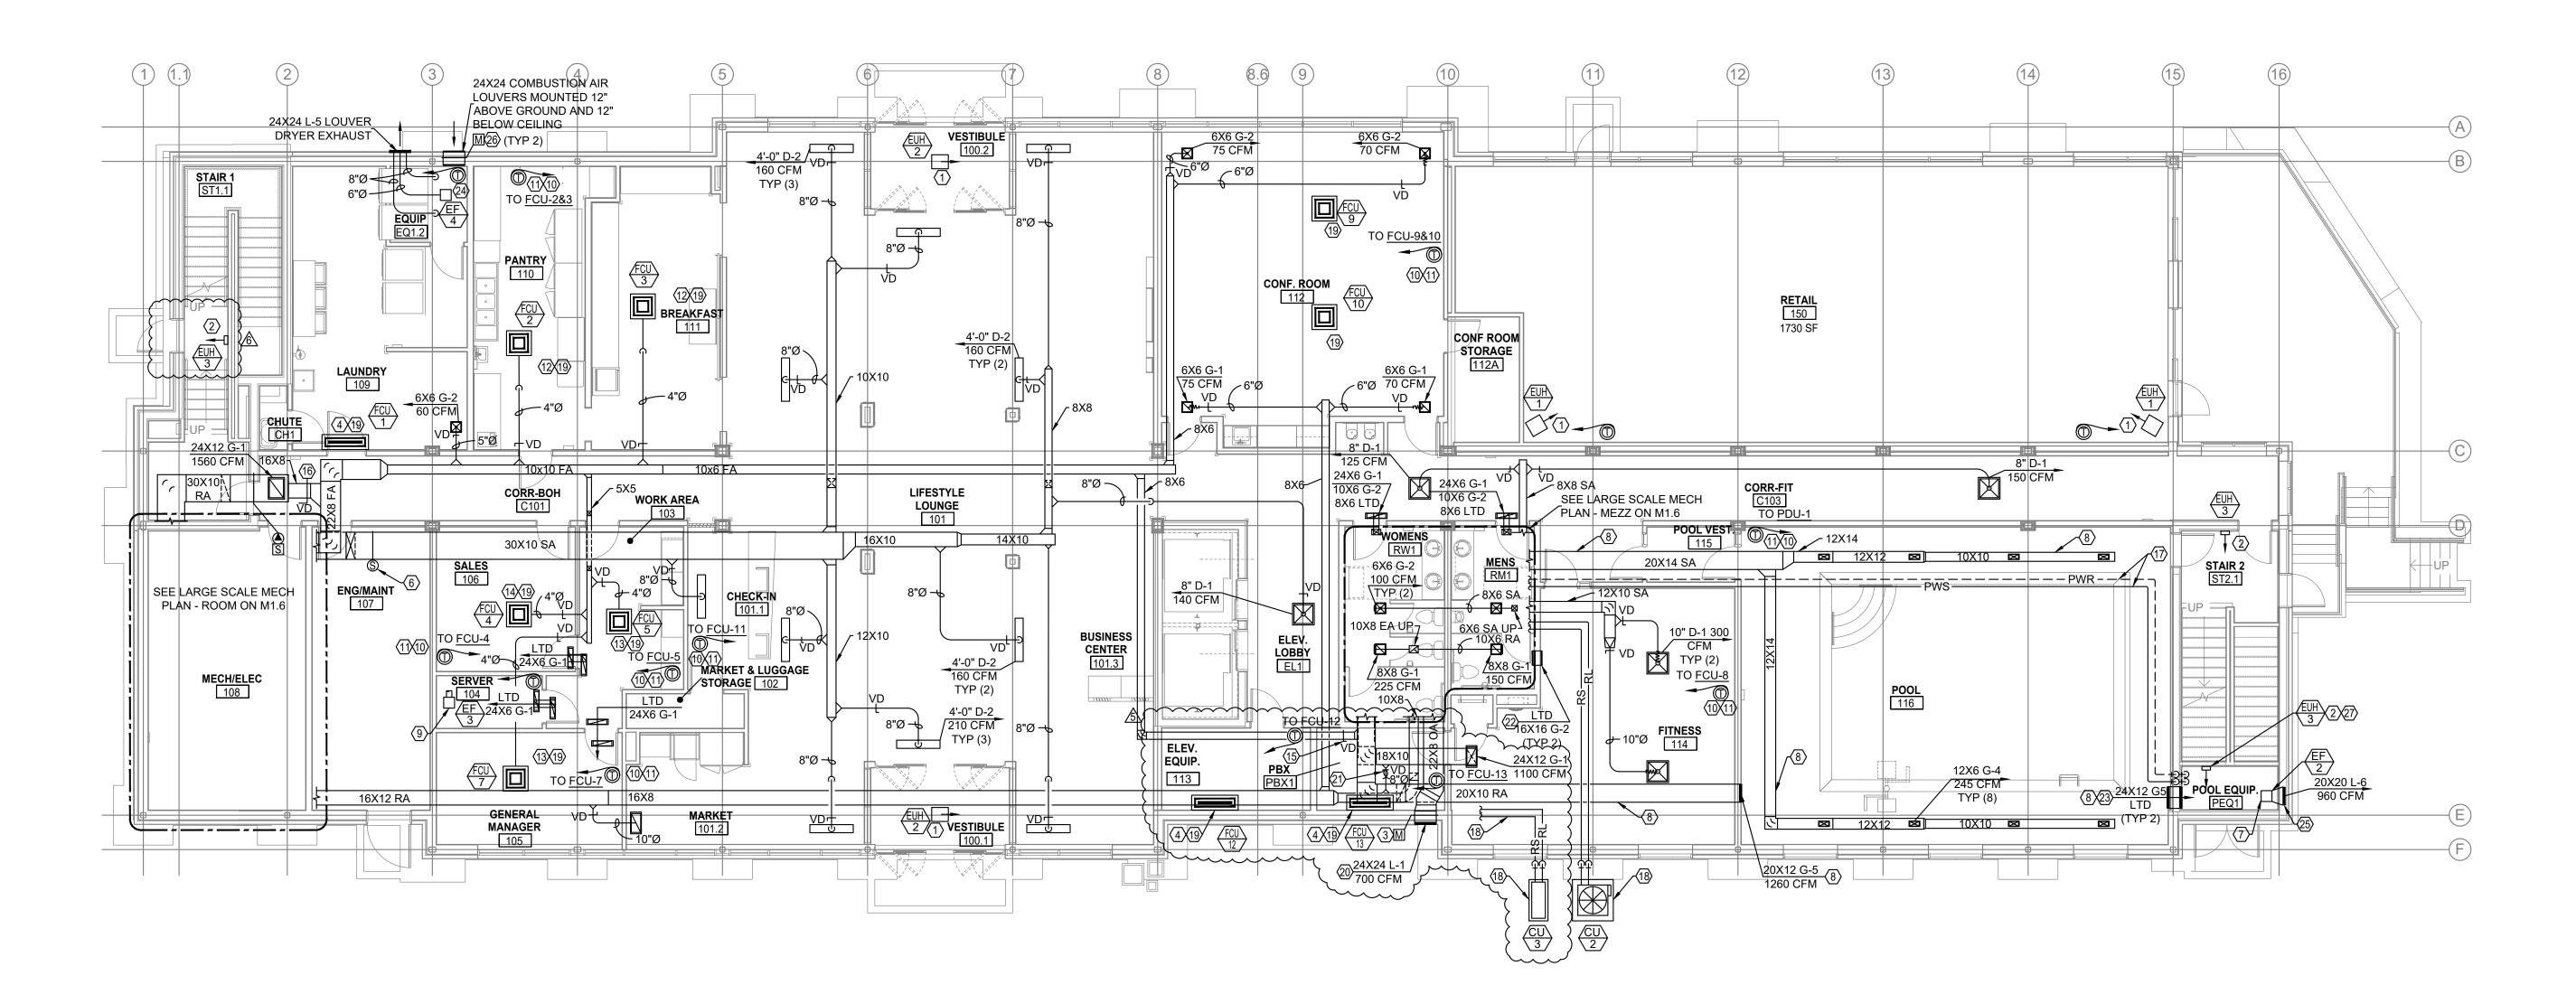



1 LEVEL ONE MECHANICAL PLAN

#### KEYED MECHANICAL NOTES:

- 1. MOUNT FROM CEILING USING SUPPLIED CEILING MOUNT KIT.
- 2. MOUNT TOP AT 30" A.F.F.
- 3. INTERLOCK MOTORIZED DAMPER WITH ASSOCIATED FAN MOTOR. DAMPER SHALL OPEN WHEN FAN IS ENERGIZED. 21. BALANCE RA TO 120 CFM. DAMPER SHALL CLOSE WHEN FAN IS DE-ENERGIZED.
- 4. MOUNT BOTTOM OF FCU AT 7'-0" A.F.F.
- 5. TERMINATE DRYER EXHAUST 12'-0" A.F.F. EXHAUST THROUGH XVENT 6SEB-BR OR SIMILAR.
- 6. PROVIDE AND INSTALL SMOKE DETECTOR. SMOKE DETECTOR PROVIDED AND INSTALLED BY MECHANICAL CONTRACTOR. UNIT TO BE WIRED BY ELECTRICAL CONTRACTOR. UNIT TO BE OF SAME MANUFACTURER AS THE FIRE ALARM SYSTEM.
- 7. PROVIDE EXPANED ALUMINUM GRATE OVER INLET.
- 8. ALUMINUM DUCTWORK ONLY ON SYSTEMS OPERATING IN 28. ROUTE RL/RS LINES FROM CU-3 TO FCU-12 AND FCU-13. POOL AREA.
- 9. DISCHARGE FAN EXHAUST TO PLENUM SPACE. INTERLOCK EF WITH LOW VOLTAGE THERMOSTAT.
- 10. MOUNT THERMOSTAT AT 50" A.F.F.
- 11. PROVIDE WITH LOCKING COVER.
- 12. BALANCE FA TO 40 CFM.
- 13. BALANCE FA TO 20 CFM.
- 14. BALANCE FA TO 15 CFM.
- 15. BALANCE FA TO 120 CFM.
- 16. BALANCE FA TO 460 CFM.
- 17. ROUTE WATER FROM POOL PUMP TO POOL DEHUMIDIFICATION UNIT. SEE POOL DEHUMIDIFICATION UNIT INSTRUCTIONS FOR SPECIFICS.
- 18. PROVIDE EQUIPMENT PAD 6" WIDER THAN OUTSIDE DIMENSIONS OF EQUIPMENT.

- 19. ROUTE RL/RS LINES PER MANUFACTURER'S SUPPLIED DRAWING, SEE SHEET M4.0.
- 20. MOUNT BOTTOM AT 13'-6" A.F.F.
- 22. MOUNT BOTTOM OF LTD AT 11'-0" A.F.F. IN FITNESS AREA.
- 23. MOUNT BOTTOM OF LTD AT 8'-0" A.F.F.
- 24. INTERLOCK THERMOSTAT WITH EF-4.
- 25. MOUNT TOP OF LOUVER AT 8'-0" A.F.F.
- 26. INTERLOCK COMBUSTION AIR DAMPER WITH CLOTHES DRYER.
- 27. EPOXY BASED POWDER COAT PAINT FOR CORROSION RESISTANCE.



#### GENERAL NOTES:

INSTALLATION.

1. LIMITED CEILING CLEARANCE THROUGHOUT LOBBY,


COORIDORS, AND FITNESS AREA, COORDINATE WITH ALL TRADES BEFORE BEGINNING FABRICATION AND/OR

LINE TYPES:

RL — REFRIGERANT LIQUID LINE
 RS — REFRIGERANT SUCTION LINE



LEVEL ONE MECHANICAL PLAN

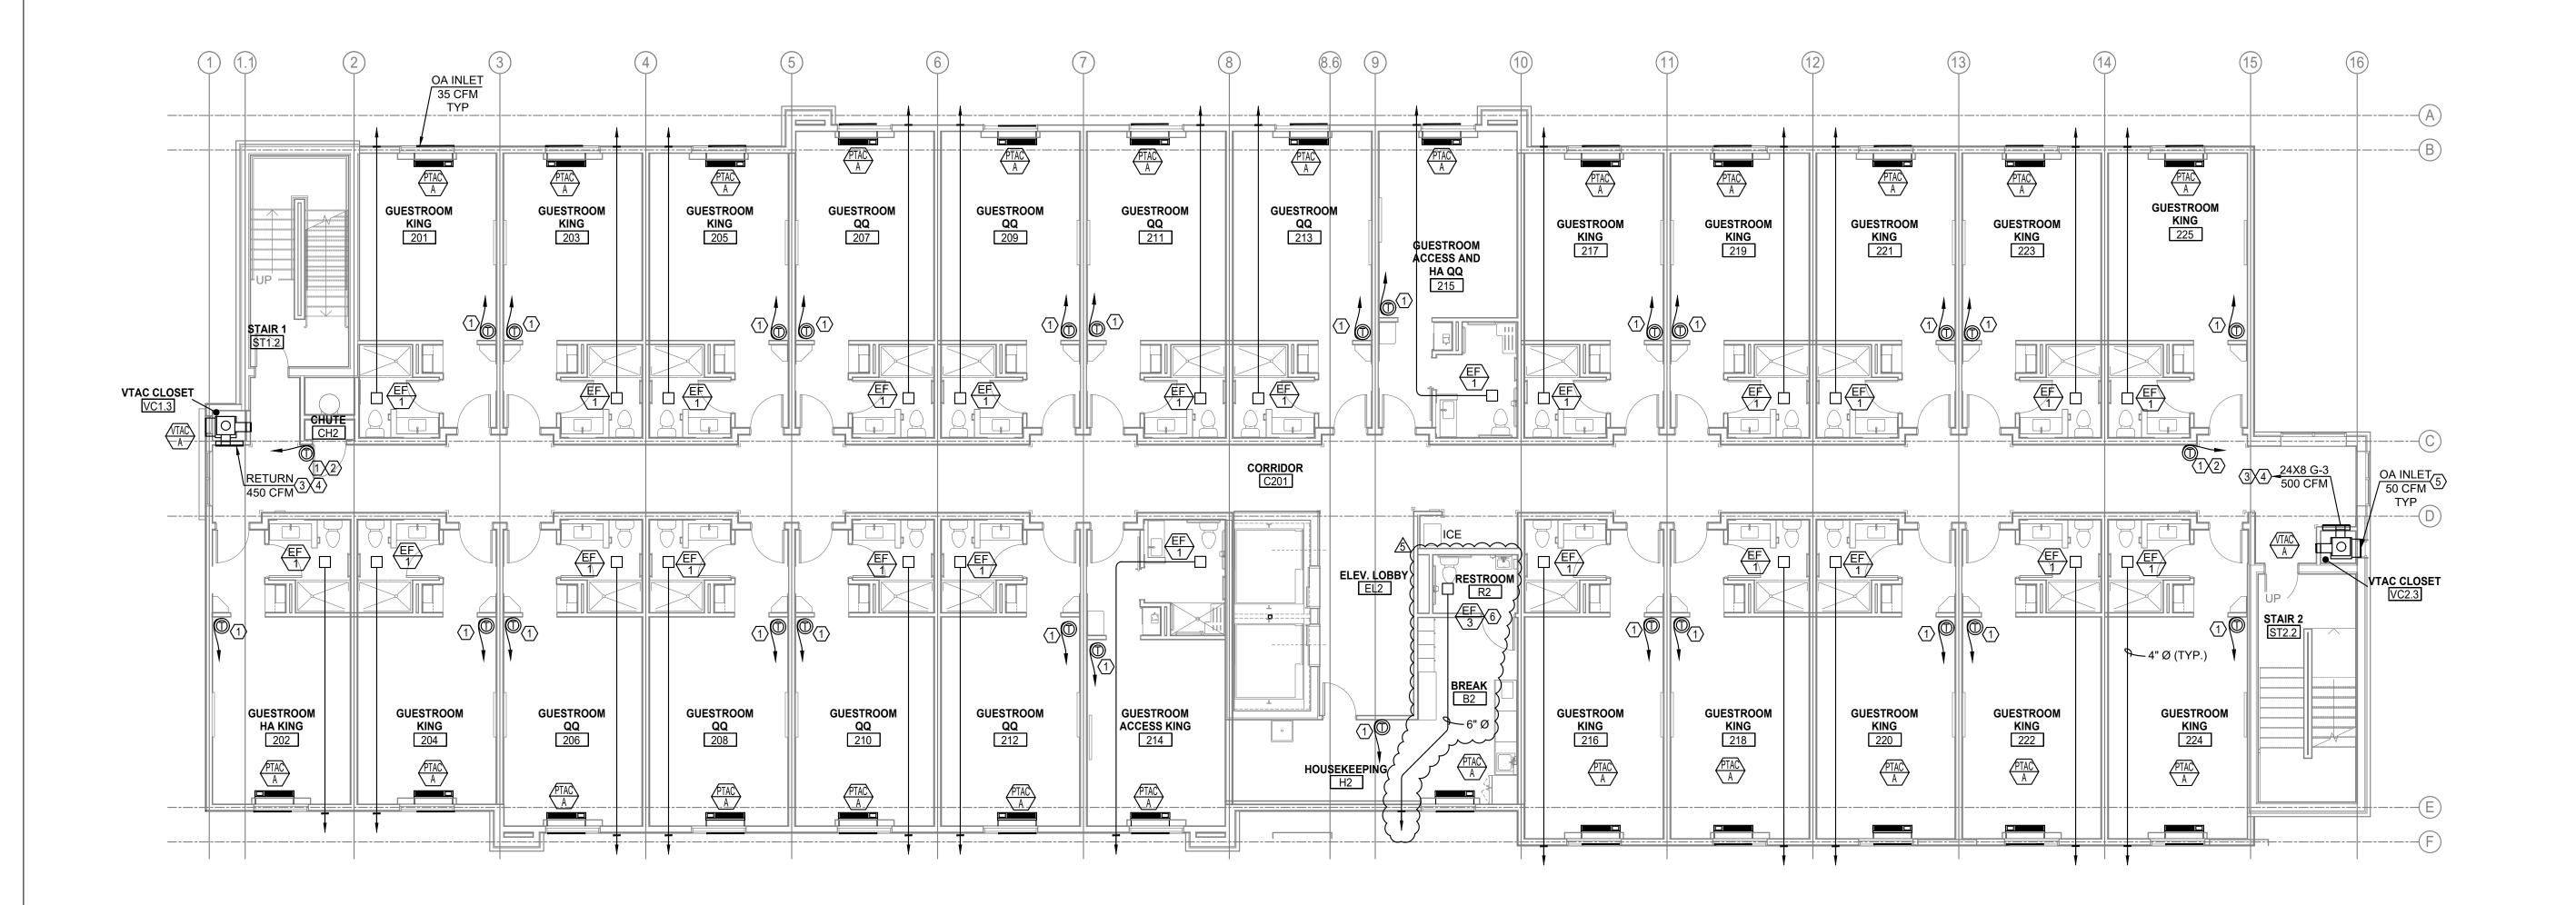

1 LEVEL TWO MECHANICAL PLAN

### KEYED MECHANICAL NOTES:

- 1. INSTALL THERMOSTAT AT 50" A.F.F.
- 2. PROVIDE WITH LOCKING COVER.
- 3. MOUNT ACCESS PANEL WITH RETURN GRILL ACCORDING TO MANUFACTURERS INSTRUCTIONS.
- 4. MOUNT SUPPLY GRILL 7'-10" A.F.F. SEE VTAC CLOSET DETAIL.
- 5. BALANCE OA FOR VTAV-A TO 50 CFM.
- 6. INTERLOCK WITH LIGHT SWITCH.




NOT DISCLOSED

LEVEL TWO MECHANICAL PLAN





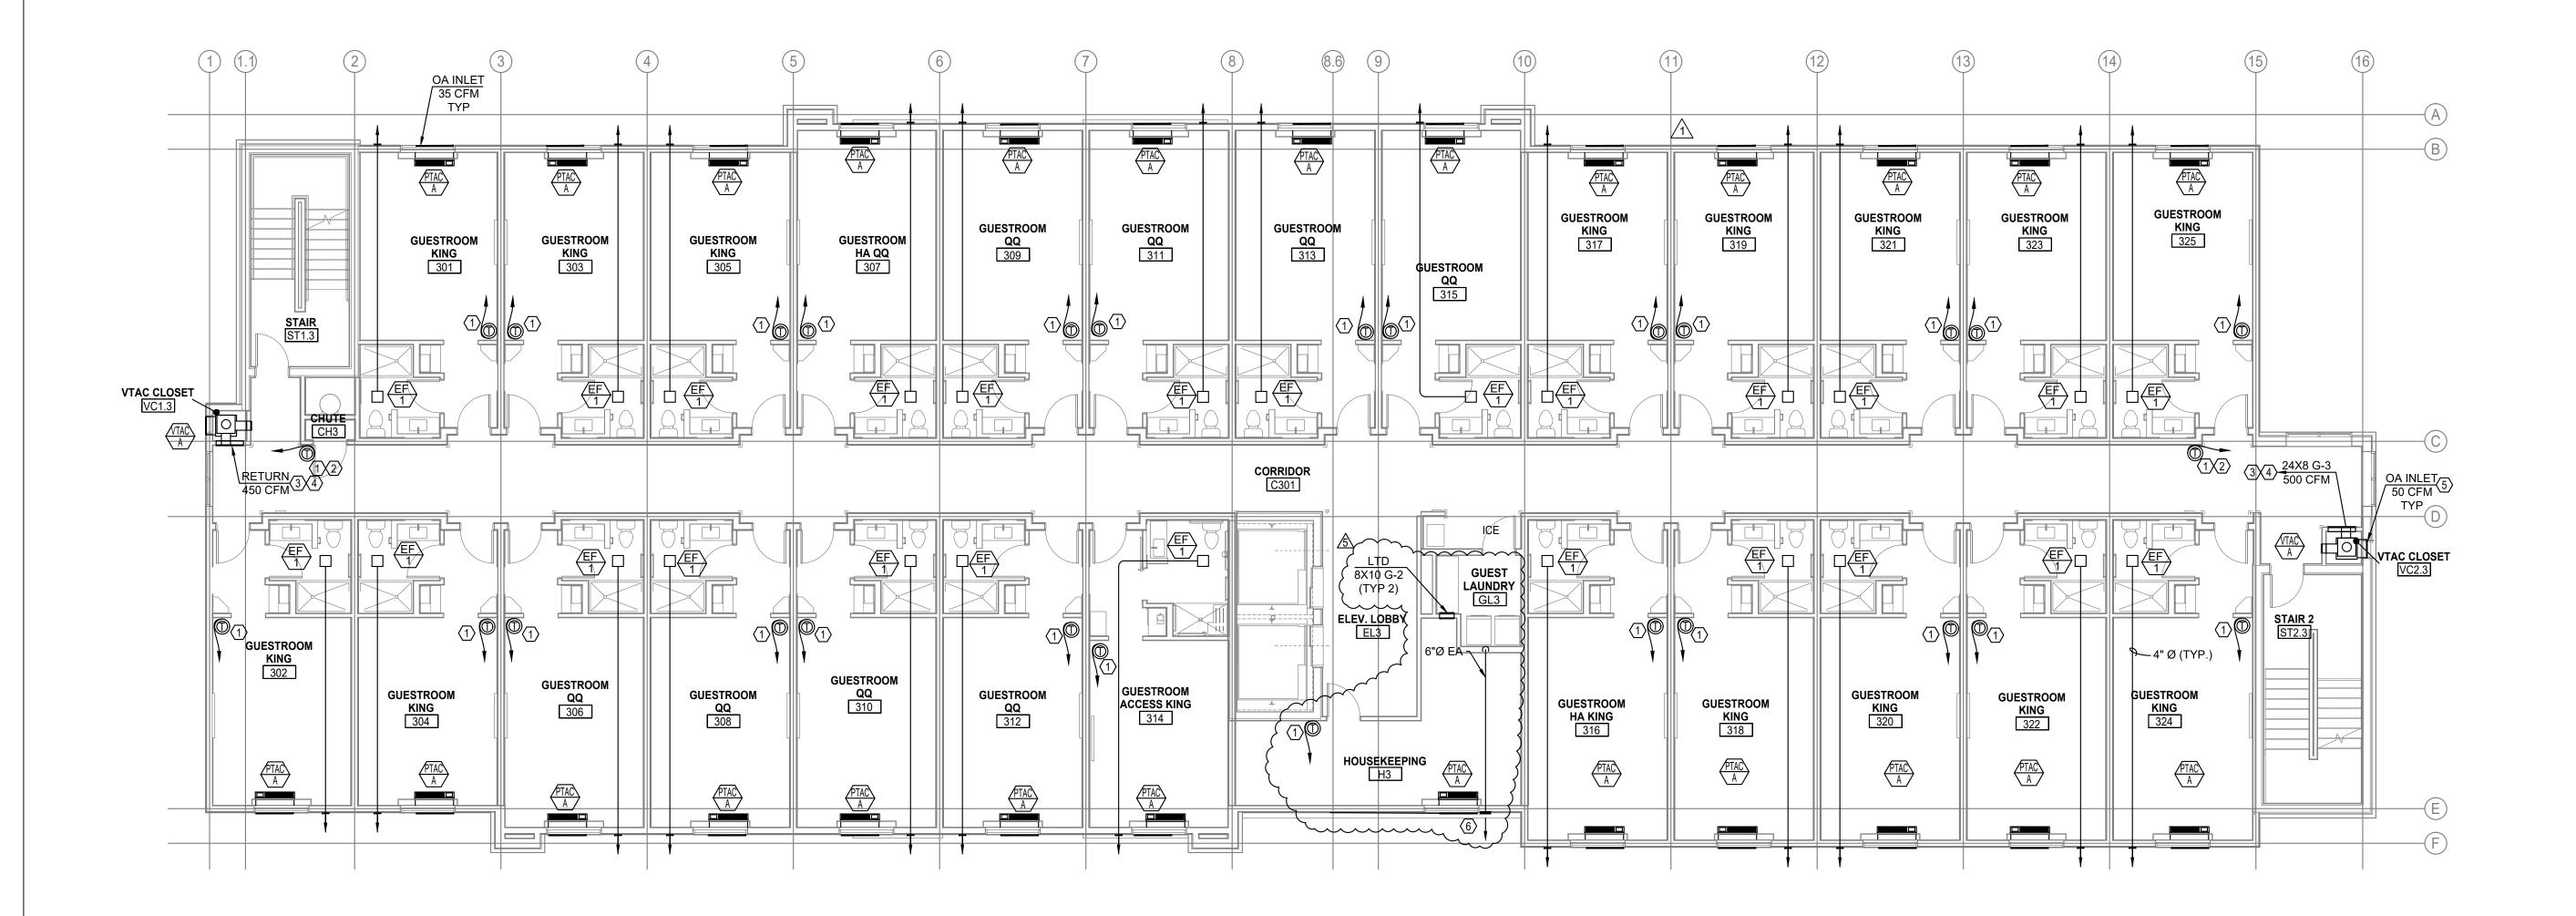

9/2016 8:54:10 AM

1 LEVEL THREE MECHANICAL PLAN

### KEYED MECHANICAL NOTES: ③


- 1. INSTALL THERMOSTAT AT 50" A.F.F.
- 2. PROVIDE WITH LOCKING COVER.
- MOUNT ACCESS PANEL WITH RETURN GRILL ACCORDING TO 3. MANUFACTURERS INSTRUCTIONS.
- 4. MOUNT SUPPLY GRILL 7'-10" A.F.F. SEE VTAC CLOSET DETAIL.
- 5. BALANCE OA FOR VTAV-A TO 50 CFM.
- 6. TERMINATE DRYER EXHAUST 12'-0" A.F.F. EXHAUST THROUGH XVENT 6SEB-BR OR SIMILAR.

NOT DISCLOSED

### LEVEL THREE MECHANICAL PLAN





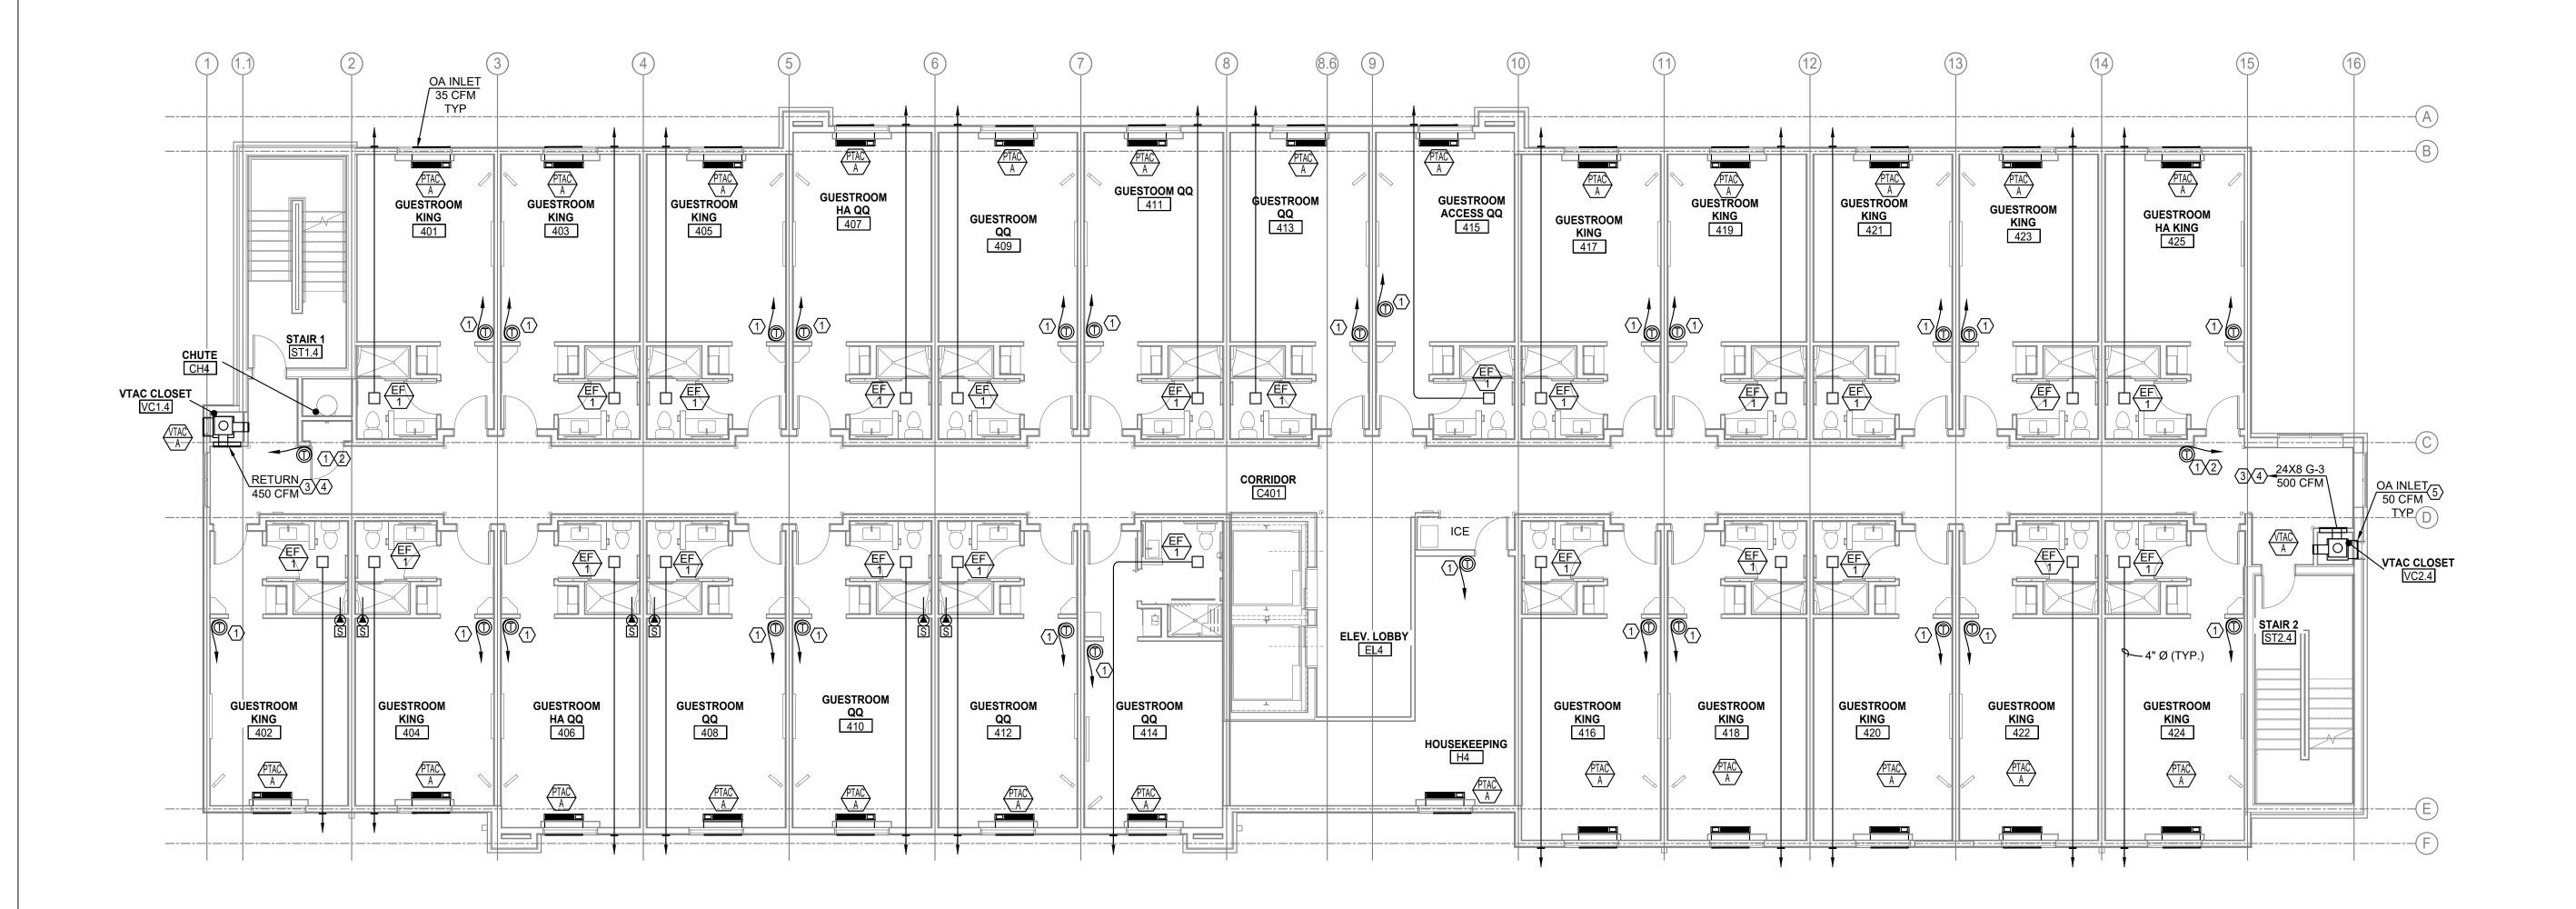

1 LEVEL FOUR MECHANICAL PLAN

#### KEYED MECHANICAL NOTES:

- 1. INSTALL THERMOSTAT AT 50" A.F.F.
- 2. PROVIDE WITH LOCKING COVER.
- 3. MOUNT ACCESS PANEL WITH RETURN GRILL ACCORDING TO MANUFACTURERS INSTRUCTIONS.
- 4. MOUNT SUPPLY GRILL 7'-10" A.F.F. SEE VTAC CLOSET DETAIL.
- 5. BALANCE OA FOR VTAV-A TO 50 CFM.




NOT DISCLOSED

LEVEL FOUR MECHANICAL PLAN





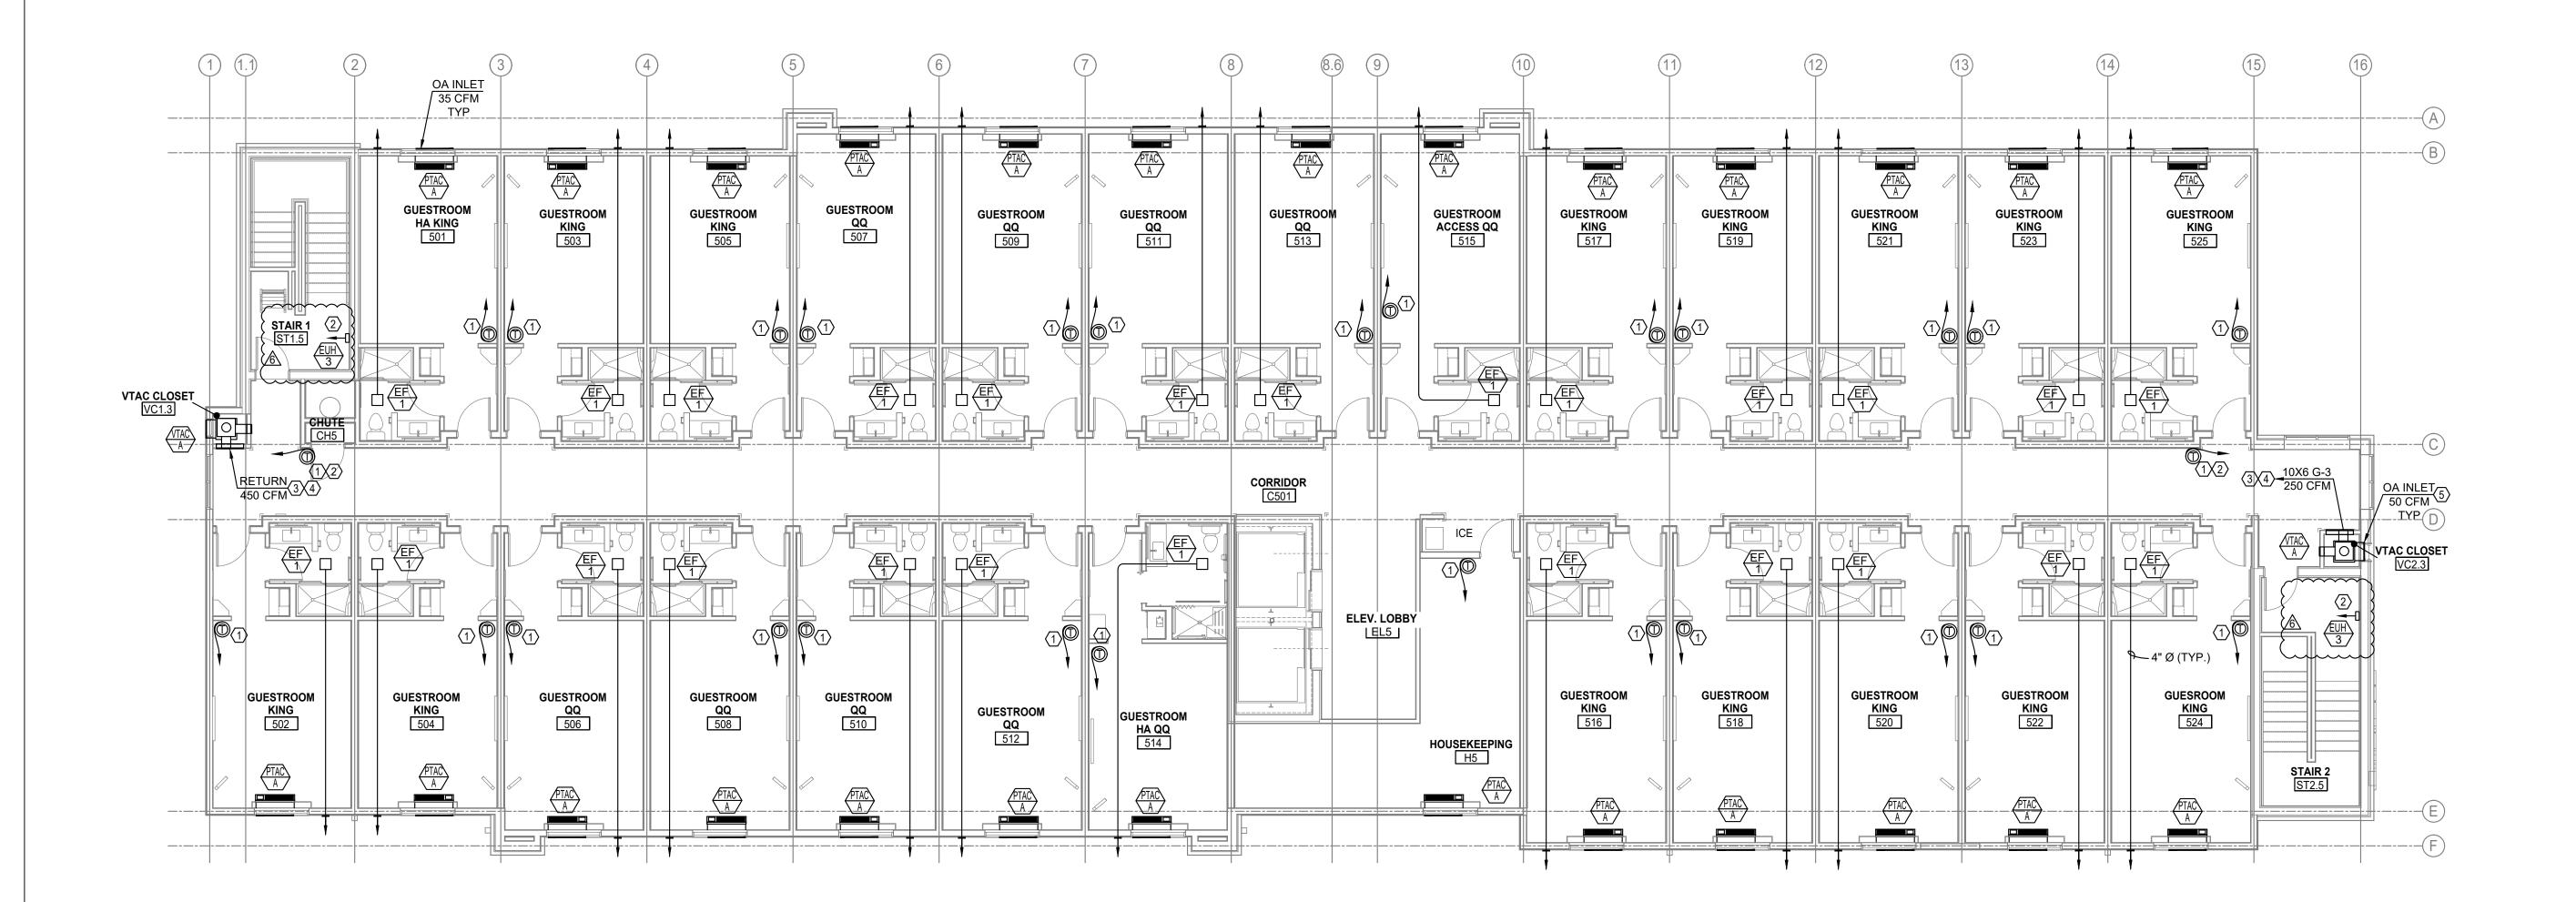

Printed On: 9/19/2016 8:54:10 AM

1 LEVEL FIVE MECHANICAL PLAN

### KEYED MECHANICAL NOTES:

- 1. INSTALL THERMOSTAT AT 50" A.F.F.
- 2. PROVIDE WITH LOCKING COVER.
- 3. MOUNT ACCESS PANEL WITH RETURN GRILL ACCORDING TO MANUFACTURERS INSTRUCTIONS.
- 4. MOUNT SUPPLY GRILL 7'-10" A.F.F. SEE VTAC CLOSET DETAIL.
- 5. BALANCE OA FOR VTAV-A TO 50 CFM.




NOT DISCLOSED

LEVEL FIVE MECHANICAL PLAN





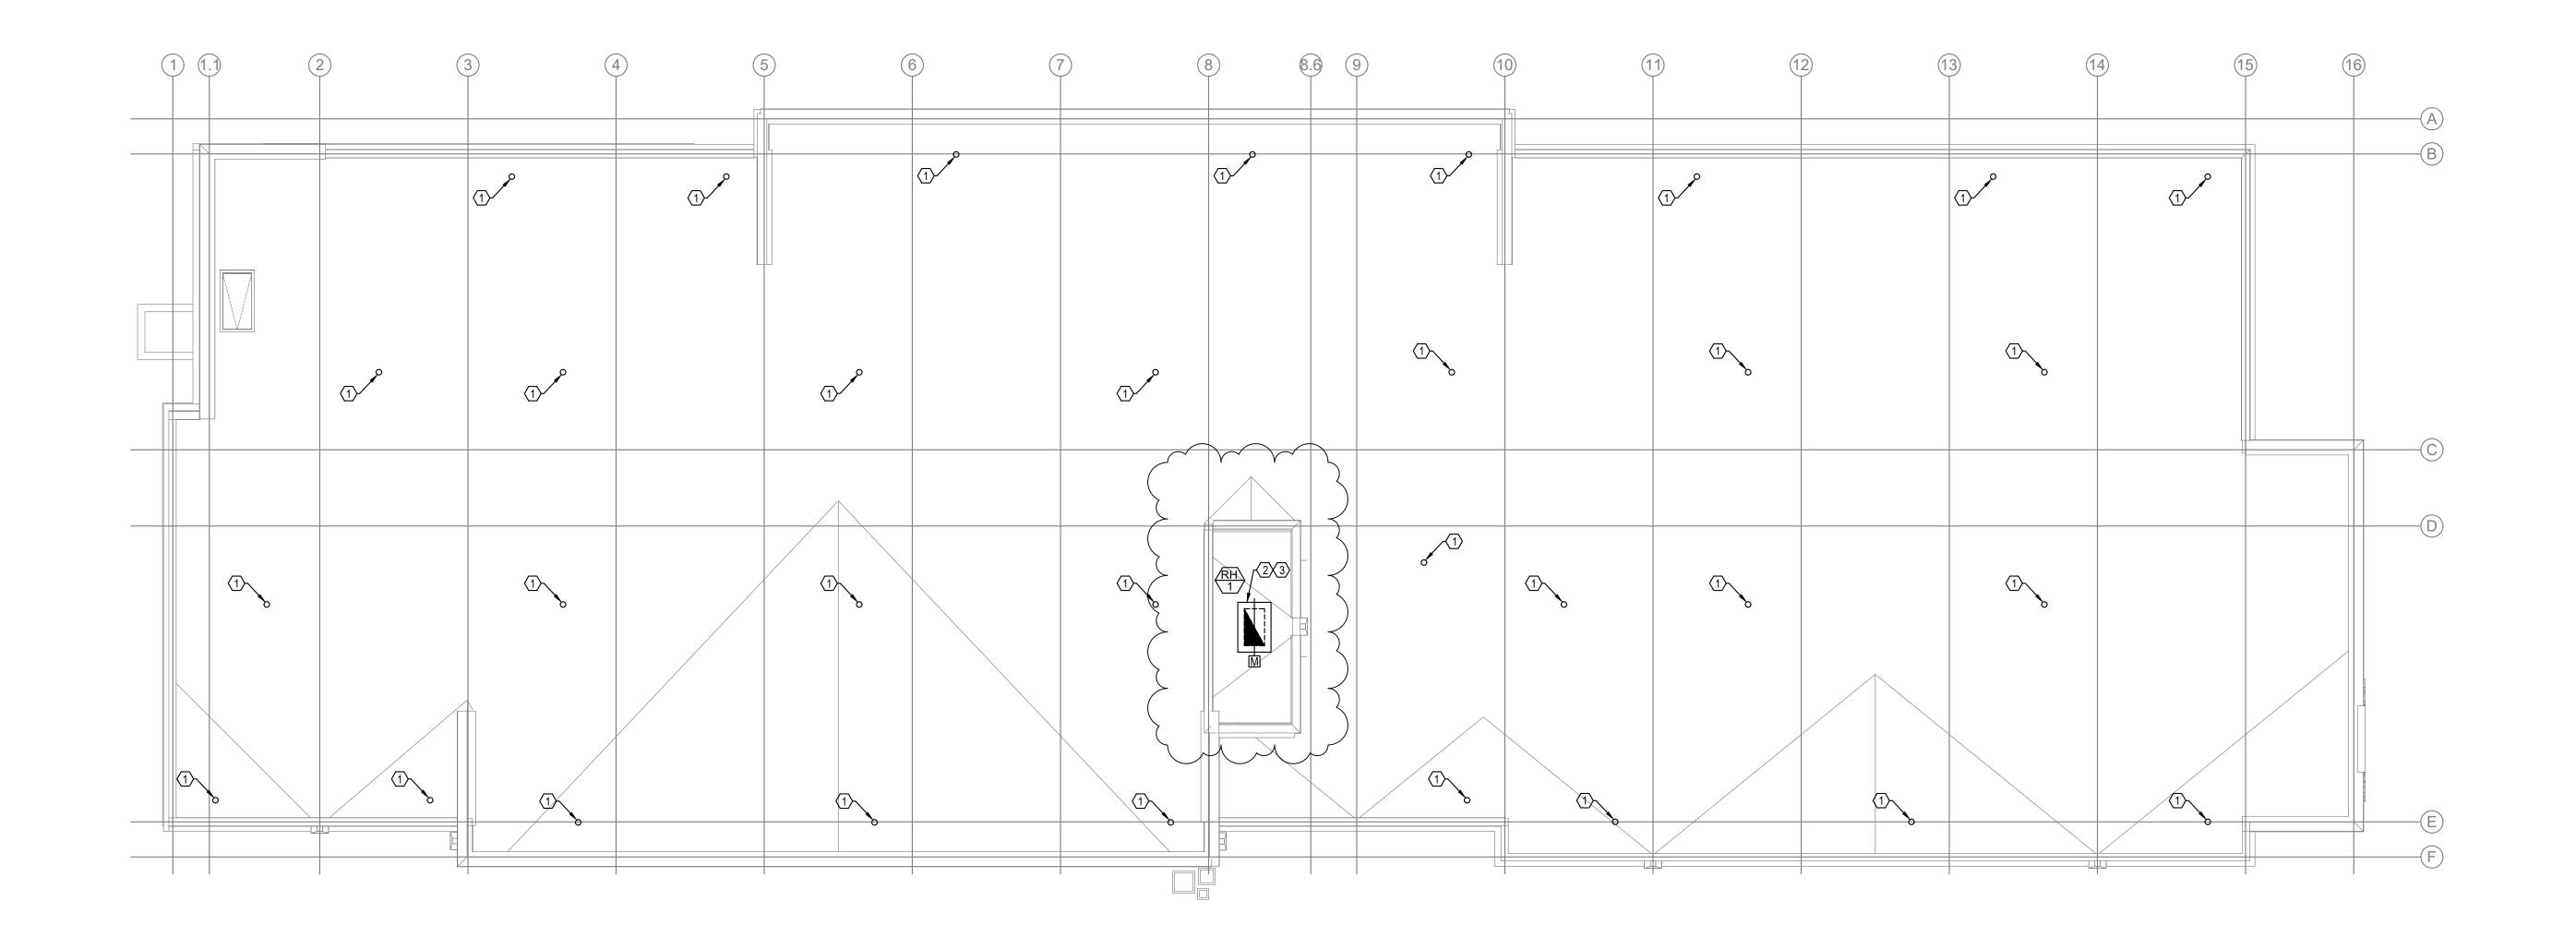

1 ROOF MECHANICAL PLAN

### KEYED MECHANICAL NOTES:

- 1. 4" VTR. SEAL PENETRATION WEATHER TIGHT.
- 2. SEAL PENETRATION WEATHER TIGHT.
- 3. INTERLOCK MOTORIZED DAMPER WITH FAC PANEL. DAMPER SHALL FAIL OPEN.



NOT DISCLOSED


ROOF MECHANICAL PLAN









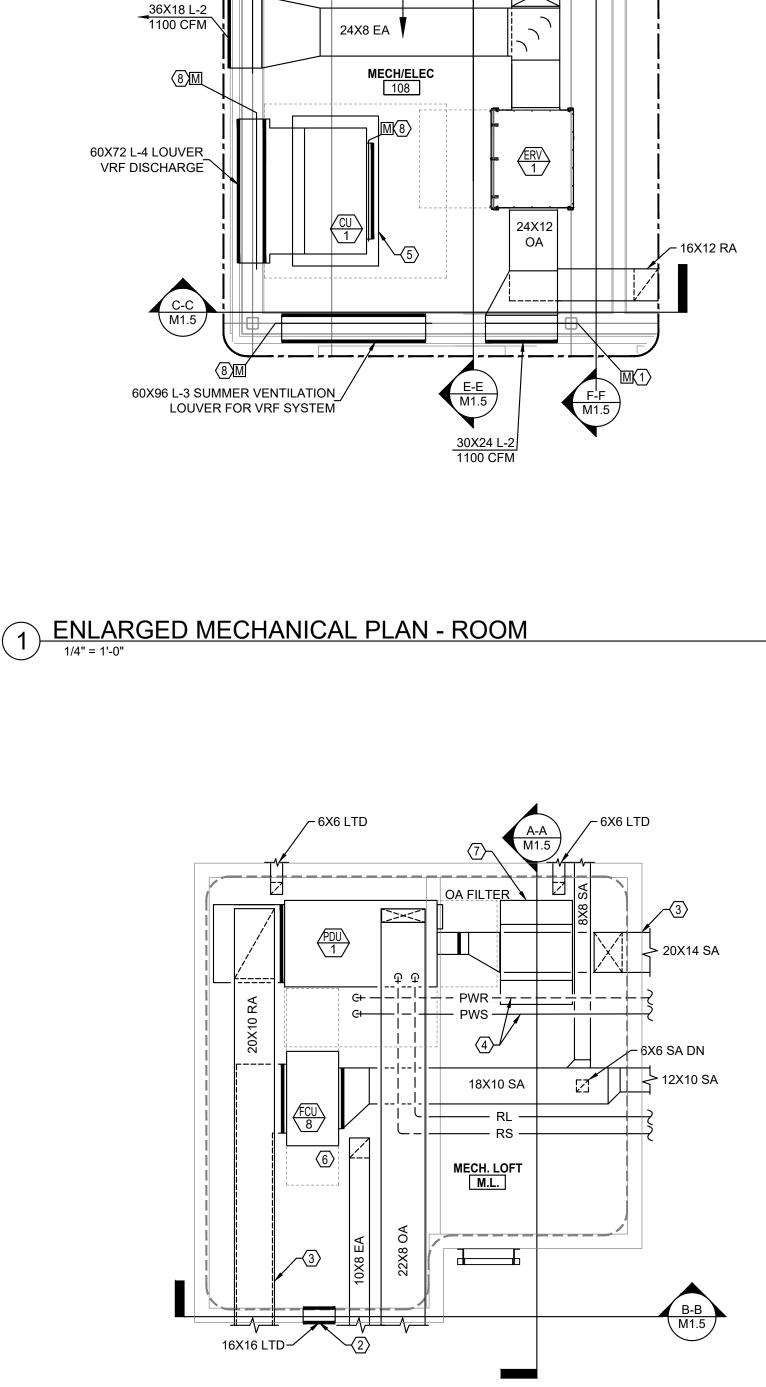

30X10

RA

TO <u>GUH-1</u>

HORIZONTAL

VENT TERMINAL &

COMBUSTION AIR

INLET ASSEMBLY

6 RFS

22X8

30X10

\$A

FCU 6


— 24X12 FA


SA


VENT TERMINAL & COMBUSTION AIR INLET ASSEMBLY


NORTH


10

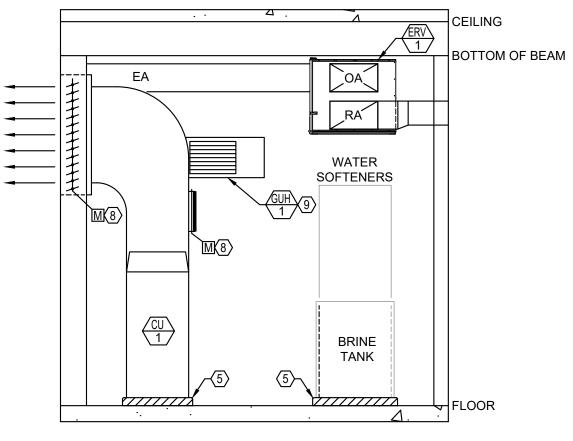


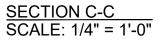


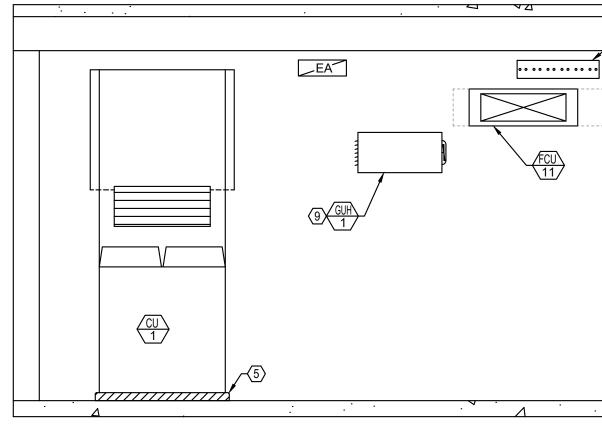

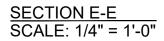


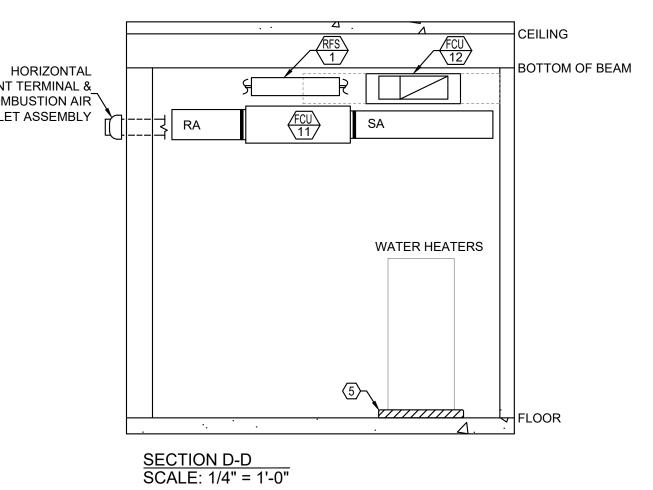

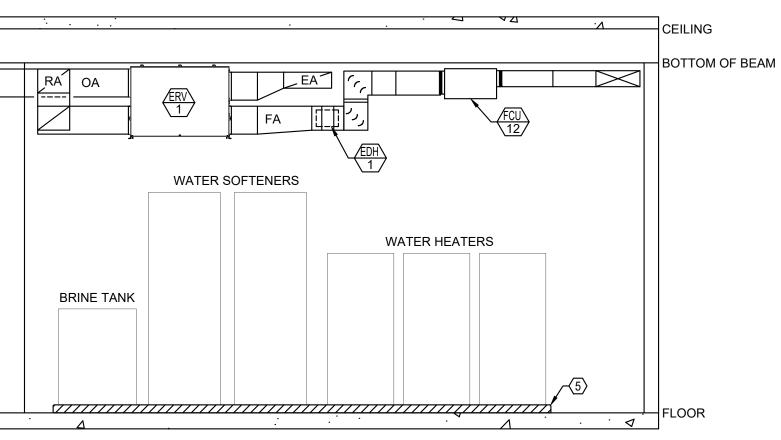

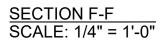


DETAIL THROUGH SECTION E-E CUTTING LINE

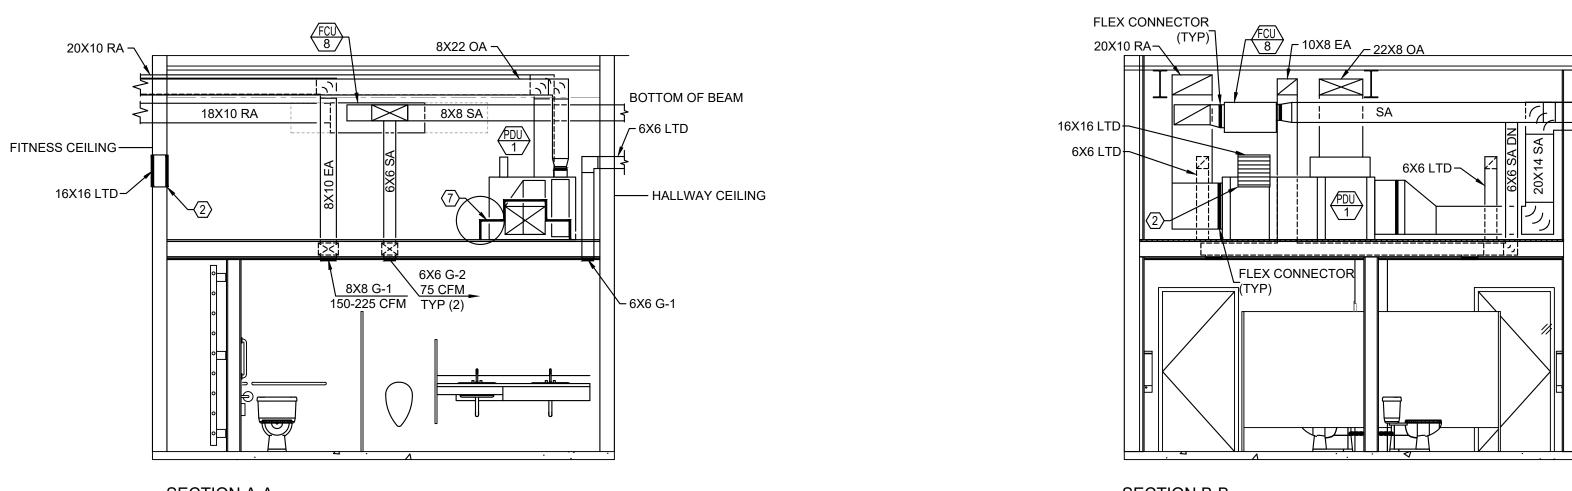

<u>SECTION A-A</u> SCALE: 1/4" = 1'-0"

### KEYED MECHANICAL NOTES: 🐼

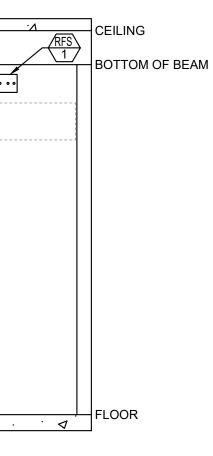

- 1. INTERLOCK MOTORIZED DAMPER WITH ASSOCIATED FAN MOTOR.
- 2. MOUNT BOTTOM OF LTD AT 11'-0" A.F.F. IN FITNESS ROOM. (NOTE: MOUNT AT 2'-3" A.F.F IN MECH MEZZ.)
- 3. ALUMINUM DUCTWORK ONLY ON SYSTEMS OPERATING IN POOL AREA.
- 4. ROUTE WATER FROM POOL PUMP TO POOL DEHUMIDIFICATION UNIT. SEE POOL DEHUMIDIFICATION UNIT INSTRUCTIONS FOR SPECIFICS.
- 5. PROVIDE EQUIPMENT PAD 6" WIDER THAT OUTSIDE DIMENSIONS OF EQUIPMENT.
- 6. ROUTE RL/RS LINES PER MANUFACTURER'S SUPPLIED DRAWING, SEE SHEET M4.0.
- 7. PROVIDE SERVICE PLATFORM OVER SUPPLY DUCTWORK. PLATFORM TO BE AT LEAST 3'-0" WIDE OR AS DIRECTED BY AHJ.
- 8. SEE SEQUENCE OF OPERATIONS FOR VRF MOTOR DAMPER OPERATION ON SHEET M2.0.
- 9. MOUNT BOTTOM OF GUH-1 AT 9'-6" A.F.F.

RL — REFRIGERANT LIQUID LINE
 RS — REFRIGERANT SUCTION LINE

LINE TYPES:

<u>SECTION B-B</u> SCALE: 1/4" = 1'-0" LADDER AND WALL NOT SHOWN FOR CLARITY.



### ENLARGED MECHANICAL PLANS

NOT DISCLOSED

Sheet No. | M1.6

	ENER	GY RECOVERY VE	NTILATOR													ECTRICAL	
					SEASON				INTER IBIENT	WINTI RETU	ER 🛛	NG SEASON VENTILATOF LAT	ΙΟΙΑ				
N	/ARK	CFM CFM DB (°F)	WB DE (°F) (°F	B REL		/B CAI F) (MB		DB	WB	DB	REL	DB WB (°F) (°F)	CAP (MBH		V PH	HP FLA M	
E	RV-1	1100 1100 95	75 75	,	80.1 67	,	5 6.1	-7	-9			50.2 40.8	35.4	23.5	208 3	1.5 4.8 1	15 10.
_	OTES	<u>S:</u> PROVIDE WITH HAN				STRUCTU	RE										
	2. F	PROVIDE WITH VIBE	RATION ISOL	ATION KIT					IS								
_		UST FANS															
						F	AN DATA										
N	MARK		WHEE				FAN RPM	DRIVE TYPE		W	FLA	V PH V	WEIGHT	SONES E	BASIS OF DE	ESIGN	NOTES
	EF-1	GUEST BATHRO				(IN WG) 0.250	850					115 1	10		REENHECK	SP-180	1,2,5,7,8
	EF-2					0.250	1358	BELT				115     1	39		EENHECK S		1,2,3
	EF-3	RESTROOM (R3 SERVER (104)			JST 75	0.250	700	DIRECT	т - 2	20.0	0.65	115 1	10	1.3 GI	REENHECK	SP-B90	(1,2,8
	EF-4	LAUNDRY EQUI			JST 260	.226	1050	DIRECT	т -	81	0.72	115 1	24	2.5 GF	REENHECK	SP-A290	1,2,4,6
	OTES	-								·							
	. PF	ROVIDE WITH BACK	GRAL DISCO	NNECT.													
4.	. PF	ROVIDE WITH ALUM ROVIDE WITH CEILII	NG MOUNT K	KIT.	COMPONEN	IS.											
5. 6.	. IN	TERLOCK WITH LIG TERLOCK WITH THI	ERMOSTAT.														
7. (8.		ROVIDE WITH XCEN	T BOX - MOE INE FIRE DA	DEL 4SEB-		IIVALENT.											
F	PACK	AGED TERMINAL AI	R CONDITIO	NER													
Ē			COOLING		TING A	IRFLOW	VENTILATI			N ELEC	TRICA	L DATA			SUPPLEN		
+	MAR		(MBH)	(ME	BH)	(CFM)	(CFM)			.RA	EER		HEAT (W	,			IPS MCA
	PTAC OTES		6.7	6	5.1	409	35		3.8 1	3.5	12	3.6	485	208 1	1,960	6,600 9.	.6 15
1. 2.		ROVIDE WITH WALL		IZED ALUN	MINUM EXT	ERIOR AF	RCHITECTU	RAL GF	RILLE (MAN	NUFACT	IURER	S OR APPR	OVED				
3.		TERNATIVE). DUTE CONDENSATE	E WASTE TO	CONDENS	SATE RISEF	۶.											
_		ROVIDE WITH POWE		-	SIMILAR TO	RAK315P											
V	/ERTI	CAL TERMINAL AIR						. м	AIN FAN EI	LECTRI		ΑΤΑ					
	MARK		COOLING (MBH)	HEATIN (MBH)		LOW VI	ENTILATION (CFM)	MOF			ER		AT (kW)	V PH	WT (LBS) BA	SIS OF DE	SIGN
(v	ŤĂČ-	A CORRIDORS	8.6	8.0			50				D.5	3.4	2.19	208 1 1	175 G	E AZ85H09	
<u>N</u> 1	OTES PF	<u>8:</u> ROVIDE WITH RATE		ΓΙΟΝ ΡΙ ΑΤ	FORM												
2. 3.	. PF	ROVIDE WITH EXTE	RIOR WALL F	PLENUM P	PER MANUF	ACTUREF	RS SPECIFIC	CATION	IS.								
	. PF	ROVIDE WITH 19-3/4	" X 32" EXTR			TERIOR A	RCHITECTU	JRAL G	GRILLE (MA	NUFAC	TURE	RS OR					
5.		ROVIDE WITH 20" X	,	FILTER.													
Ρ	POOLE	DEHUMIDIFICATION UN	IT														
			CFM	UPPLY FA			OMPRESSC					OR COIL		<u> </u>	DE UNIT ELI		
N	MARK				P/ ESP FAN N WC) (/	FLA A)	RI RLA L		OT COOL (MBH)	SENS ( (MB		MAX AC SENS (MBH)	MAX AO TOT (MB		PH FLA (A	) MCA M	
F	PDU-1	MECH MEZZ 19	60 700	2.2	1.0 5	.0 R41	0A 17.6 1	23.0	54.8	27.	7	32.8	61.2	208	3 92.0	114 1	125 2
N	OTES	_															
1. 2.	. PF	JTDOOR CONDENS	TION LINE S	SET SIZED													
3.		ROVIDE WITH REQU		DRS AND (	CONTROLS	PER MAN	IUFACTURE	R'S RE									
	MA			PHASE	AMPS B	ASIS OF [	DESIGN	NOTE		DOF HO							
	EUI		208	3				2,3		чк∣ с	FM	MAX PRES DROP		OOD OVERA (L x W x		THROAT S (L x W)	
₽	EUI		208 208	1		QMARK CI ARK CWF	DF-558 11208DSF	2, 5 1, 2, 4		-1	-	0.1		54 x 36 x	16	40 x 22	
С И	OTES				li				<u>NOTE</u>								
	1. F	PROVIDE WITH MOU PROVIDE WITH INTE				AL THERN	MOSTAT.		1. 2.	PROV	IDE WI	TH INSECT	ZED DAM	IPER.			
	3. F					POLE THE			3. 4.			MOTORIZED ER TO FAIL		R WITH FIRE POSITION.	ALARM CO	NTROL PAI	NEL.
(	4. F	PROVIDE WITH A SU PROVIDE WITH SUR					<										
$\left\{ \right\}$			AR TO CDF-	T.								LOUVER	S				
0	GAS F	RED - UNIT HEATE		1								MARK	TYPE	CFM	MAX PD	SIZE W H	D B
	MA	RK CFM OUT		VOLT PI	HASEHERT	Z DISCOI		ASIS O	F DESIGN	NC	DTES	L-1	INTAKE		``	(IN) (IN) 24 18	(IN) 4
	GUI	H-1 2256 121	.83 1/4	115	1 60	20	A I	REZNO	OR UEAS	1,2,3	3,4,5,6	L-2	INTAKE	E 1100	0.04	30 24	4
_	OTES												INTAKE EXHAUS	T 10852	0.10	72 96 60 72	4 4
	2. II	NTEGRAL 24 VDC C	STIC INDICAT									-	EXHAUS EXHAUS	-		24 24 20 20	4 4
	4. \	/ULTI-TRY DIRECT /IBRATION/NOISE I	SOLATED FA	N MOTOR	l.							NOTES:					
		PROVIDE WITH HOF PROVIDE WITH SING					ILAR TO CC	6.						TH INSECT S NG OR SIMIL		LE FOR CC	ORROSI
_													-				
		NAME								DE	SIGN	TEMP (F)			CAP	ACITY (MBI	H)
1	No						MODEL		WEIGHT	соо	LING	HEATING		ΤΟΤΑ	 ۱		
		TYPE	TAG NAME	R	ROOM				(LBS)	WB	DB	DB	RATED	CORRECTE			
┢	1	COMPACT 4-WAY	FCU-7	GEN MA	NAGER 10		HIBA-CARRI		45	80.0	67.0	70.0	12.00	12.00 (12.0	0) 9.20	13.50	0 13.5
-						MIMU	-AP0121MH2 HIBA-CARRI		-					,	,		-
┢		COMPACT 4-WAY	FCU-4		_ES 106	MMU	-AP0071MH2 HIBA-CARRI	2UL	45	80.0	67.0	70.0	7.50	7.50 (7.50)	,		
F		COMPACT 4-WAY	FCU-5		AREA 103	MMU	-AP0071MH2 HIBA-CARRI	2UL	45	80.0	67.0	70.0	7.50	7.50 (7.50	,		
	4 ⊦	IIGH STATIC DUCT	FCU-11	LOE	3BY 101	MMD	-AP0726HP-	-UL	225	80.0	67.0	70.0	72.00	72.00 (72.0	0) 37.20	0 81.00	0 81.0
	5	HIGH WALL	FCU-1	LAUN	NDRY 109	MMF	HIBA-CARRI (-AP0153H2I	UL	35	80.0	67.0	70.0	15.40	15.40 (15.4)	0) 14.00	0 17.00	0 17.0
	6	COMPACT 4-WAY	FCU-2	PAN	TRY 110		HIBA-CARRI -AP0151MH2		45	80.0	67.0	70.0	15.40	15.40 (15.4)	0) 13.70	0 17.00	0 17.0
		COMPACT 4-WAY	FCU-3	BREAK	KFAST 111	TOSI	HIBA-CARRI -AP0071MH2	ER	45	80.0	67.0	70.0	7.50	7.50 (7.50	) 0.80	8.50	) 8.5
	7										<del> </del>	1	1	36.00 (36.0	0) 04.0	0 40.00	0 40.0
F		IIGH STATIC DUCT	FCU-8	FITN	IESS 114		HIBA-CARRI D-AP0364H2		130	80.0	67.0	70.0	36.00	00.00 (00.0	0) 24.00		0   40.0
┢	8		FCU-8 FCU-9		IESS 114 ROOM 112	MME TOSI	D-AP0364H2 HIBA-CARRI	UL ER	130 45	80.0 80.0	67.0 67.0	70.0 70.0	36.00 7.50	7.50 (7.50)			-
	8 F 9	HIGH STATIC DUCT	FCU-9	CONF	ROOM 112	MME TOSI MMU TOSI	D-AP0364H2 HIBA-CARRI -AP0071MH2 HIBA-CARRI	UL ER 2UL ER	45	80.0	67.0	70.0	7.50		) 6.00	8.50	) 8.5
-	8 F 9 10	HIGH STATIC DUCT COMPACT 4-WAY COMPACT 4-WAY	FCU-9 FCU-10	CONF CONF	ROOM 112 ROOM 112	MME TOSI MMU TOSI MMU TOSI	D-AP0364H2 HIBA-CARRI -AP0071MH2 HIBA-CARRI -AP0071MH2 HIBA-CARRI	UL ER 2UL ER 2UL ER	45 45	80.0 80.0	67.0 67.0	70.0	7.50 7.50	7.50 (7.50 7.50 (7.50	) 6.00	) 8.50 ) 8.50	) 8.5
	8 F 9 10	HIGH STATIC DUCT	FCU-9	CONF CONF FRE ELE	ROOM 112	MME TOSI MMU TOSI MMU TOSI MME TOSI	D-AP0364H2 HIBA-CARRI -AP0071MH2 HIBA-CARRI -AP0071MH2	UL ER 2UL ER 2UL ER UL ER	45	80.0	67.0	70.0	7.50	7.50 (7.50	) 6.00 ) 6.00 0) 32.00	) 8.50 ) 8.50 0 40.00	) 8.5 ) 8.5 0 40.0

TOSHIBA-CARRIER

MMK-AP0243H2UL

80.0 67.0 70.0

130

10 54 ω

FCU-14

HIGH WALL

PBX

AM

				1		RF CONDE	ENSING UNIT/HEA	T PUMP														
							MODEL		COOLI	NG (MBH)	HEAT	ING (MBH)	REQUIRED	D CAPACITY	CONNEC	т	MAX		ELECTRICAL			
/ICA	BASIS O	F DESIGN	WT (LBS)	NOTES		MARK	MODEL	NC	DMINAL	CORRECT			D COOLING (MBH)	HEATING (MBH)	INDOOR UNITS	DIV.	DIV.	LOCATION	V - Ø - Hz	MCA	MOCP	
10.8	RENEWAI	RE HE2X1NH	450	1,2,3		CU-1	TOSHIBA-CARR MMY-MAP1686FTS		68.00	178.02	189.00	194.75	224.30 (224.30)	251.00 (251.00)	11	134%	135%	ROOM 108	208/230 - 3 - 60	66.20	70.00	A
					{	HP-1	TOSHIBA-CARR MSP0487HD-U		48.00	-	54.00	-	-	-	2	100%	135%	EXTERIOR	208/230 - 3 - 60	36.30	40.00	<u>}</u>
					$\sim$	~~~~		~~~~	~~~	~~~~~					~~~~~~~~~~~~~~~~~~~~~~~~~~~~~~~~~~~~~~~	~~~~			~~~~~~	~~~	~~~~	
	DIFFUS	ERS, REGISTE	RS & C	GRILLĘS																		
	MARK	MAX . STAT PD (IN W.G		IAX. E NC	DAMPER (Y/N)	FRAI TYF		BASI	S OF DE	SIGN	NOTES											
ES	D-1	0.05		20	Ν	LAY			JEGER		1											
	D-2	0.05	_	15	N	LAY		KRUEGE			1											
,7,8 2,3	G-1	0.05		30	N	SURF.		_	EGER E		1											
2,8	G-2 G-3	0.05		15 15	N N	SURF.					1											
$\sim$	G-4	0.00		20	N	SURF			JEGER		1					A						
4,6	G-5	0.05		20	N	SURF			UEGER		1,2	5	~~~~~~	·····	~~~~~~~~~~~~~~~~~~~~~~~~~~~~~~~~~~~~~~~	$\sim$						
	2. AL		DESIG	GN NOTE	=S	POOL AR	REA.				{		EF	FAN DUCT	JNG	~~~~~~~~~~~~~~~~~~~~~~~~~~~~~~~~~~~~~~~	EQUI STRUC		NEL FLOOR	DED <u>ELECT</u> 36" FR 42" FR 102" T/ WHICH 30" WII	SP	KING S IT OF I IT OF I EIGHT GREA DTH C /ERIFI
NO 1,2,3	TES 3,4,5										4 M2.0	SCALE: N	HAUST		DETAIL	= 	0x20x12 SA PLENUM EXTERIOR WALL 10"Ø FLEX DUCT	.0 SCAL	E: NONE	SA RE	<b>SISTER</b> 10" AFF	R
AL	X HEAT	CONDE	NSING		ECTRICA															-VTAC	CLOSET	


	AUX	HEAT	CC		SING U	NIT ELEC	TRICAL	_		
	CAP (kW)	FLA (A)	VOLT	PH	HP	FLA (A)	MCA	MOP	BASIS OF DESIGN	NOTES
Ι	25.0	69.4	208	3	0.6	2.6	4	15	SERESCO NE-004-PH-I-A2NH1202E1C2AED	1,2,3

				ELECTR	IC DUCT HEATI	ER							
Т				MARK	SERVES	KW	VOLIS	PHASE	AMPS	WIDTH (IN)	HEIGHT (IN)	BASIS OF DESIGN	NOTES
	CURB HT	BASIS FOR DESIGN	NOTES	EDH-1	FCU-11 (	3.7	208	3	10.4	24	12	WARREN CBK-5	1,2
				NOTEO						<b>公</b>			
	14	GREENHECK WRH	1,2,3,4	NOTES:	OVIDE WITH IN					/6\			
					OVIDE WITH IN		-		ININE CT.				

BASIS OF DESIGN	NOTES
RUSKIN L375D	1
RUSKIN L375D	1,2

#### IVE ENVIRONMENT.


		CAPACI	ry (MBH)	)		ELECTRICAL						
	TOTAL			HEATING		V Ø H-		MCA	MOCR	FRO	VI (ft)	AIRFLOW (CFM)
RATED	CORRECTED	REQUIRED	RATED	CORRECTED	REQUIRED	V - Ø - HZ	FLA	MCA	MOCP	OUTDOOR	BRANCH	
12.00	12.00 (12.00)	9.20	13.50	13.50 (13.50)	13.10	208/230 - 1 - 60	0.4	0.5	15	42.0	18.0	330
7.50	7.50 (7.50)	1.10	8.50	8.50 (8.50)	1.20	208/230 - 1 - 60	0.4	0.5	15	42.0	18.0	320
7.50	7.50 (7.50)	1.10	8.50	8.50 (8.50)	1.20	208/230 - 1 - 60	0.4	0.5	15	52.8	28.8	320
72.00	72.00 (72.00)	37.20	81.00	81.00 (81.00)	43.70	208/230 - 1 - 60	4.6	5.7	15	24.0	6.0	2200
15.40	15.40 (15.40)	14.00	17.00	17.00 (17.00)	1.90	208/230 - 1 - 60	0.4	0.5	15	60.0	36.0	490
15.40	15.40 (15.40)	13.70	17.00	17.00 (17.00)	1.70	208/230 - 1 - 60	0.5	0.7	15	73.2	6.0	390
7.50	7.50 (7.50)	0.80	8.50	8.50 (8.50)	0.90	208/230 - 1 - 60	0.4	0.5	15	79.2	12.0	320
36.00	36.00 (36.00)	24.00	40.00	40.00 (40.00)	15.00	208/230 - 1 - 60	2.93	2.34	15	42.0	12.0	1100
7.50	7.50 (7.50)	6.00	8.50	8.50 (8.50)	6.00	208/230 - 1 - 60	0.4	0.5	15	54.0	12.0	320
7.50	7.50 (7.50)	6.00	8.50	8.50 (8.50)	6.00	208/230 - 1 - 60	0.4	0.5	15	54.0	12.0	320
36.00	36.00 (36.00)	32.00	40.00	40.00 (40.00)	23.00	208/230 - 1 - 60	2.93	2.34	15	36.0	12.0	1100
24.00	24.00 (24.00)	24.00	27.00	27.00 (27.00)	-	208/230 - 1 - 60	0.4	0.5	15	-		-
24.00	24.00 (24.00)	24.00	27.00	27.00 (27.00)	-	208/230 - 1 - 60	0.4	0.5	15	-	-	-
	12.00 7.50 7.50 72.00 15.40 15.40 7.50 36.00 7.50 36.00 24.00	RATED         CORRECTED           12.00         12.00 (12.00)           7.50         7.50 (7.50)           7.50         7.50 (7.50)           72.00         72.00 (72.00)           15.40         15.40 (15.40)           15.40         15.40 (15.40)           7.50         7.50 (7.50)           36.00         36.00 (36.00)           7.50         7.50 (7.50)           36.00         36.00 (36.00)           24.00         24.00 (24.00)	TOTAL           RATED         CORRECTED         REQUIRED           12.00         12.00 (12.00)         9.20           7.50         7.50 (7.50)         1.10           7.50         7.50 (7.50)         1.10           72.00         72.00 (72.00)         37.20           15.40         15.40 (15.40)         14.00           15.40         15.40 (15.40)         13.70           7.50         7.50 (7.50)         0.80           36.00         36.00 (36.00)         24.00           7.50         7.50 (7.50)         6.00           36.00         36.00 (36.00)         32.00           24.00         24.00 (24.00)         24.00	TOTAL         RATED         CORRECTED         REQUIRED         RATED           12.00         12.00 (12.00)         9.20         13.50           7.50         7.50 (7.50)         1.10         8.50           7.50         7.50 (7.50)         1.10         8.50           72.00         72.00 (72.00)         37.20         81.00           15.40         15.40 (15.40)         14.00         17.00           15.40         15.40 (15.40)         13.70         40.00           7.50         7.50 (7.50)         0.80         8.50           36.00         36.00 (36.00)         24.00         40.00           7.50         7.50 (7.50)         6.00         8.50           36.00         36.00 (36.00)         32.00         40.00           24.00         24.00 (24.00)         24.00         27.00	RATED         CORRECTED         REQUIRED         RATED         CORRECTED           12.00         12.00 (12.00)         9.20         13.50         13.50 (13.50)           7.50         7.50 (7.50)         1.10         8.50         8.50 (8.50)           7.50         7.50 (7.50)         1.10         8.50         8.50 (8.50)           72.00         72.00 (72.00)         37.20         81.00         81.00 (81.00)           15.40         15.40 (15.40)         14.00         17.00         17.00 (17.00)           15.40         15.40 (15.40)         13.70         17.00         17.00 (17.00)           7.50         7.50 (7.50)         0.80         8.50         8.50 (8.50)           36.00         36.00 (36.00)         24.00         40.00         40.00 (40.00)           7.50         7.50 (7.50)         6.00         8.50         8.50 (8.50)           36.00         36.00 (36.00)         32.00         40.00         40.00 (40.00)           24.00         24.00 (24.00)         24.00         27.00 (27.00)	TOTAL         HEATING           RATED         CORRECTED         REQUIRED         RATED         CORRECTED         REQUIRED           12.00         12.00 (12.00)         9.20         13.50         13.50 (13.50)         13.10           7.50         7.50 (7.50)         1.10         8.50         8.50 (8.50)         1.20           7.50         7.50 (7.50)         1.10         8.50         8.50 (8.50)         1.20           72.00         72.00 (72.00)         37.20         81.00         81.00 (81.00)         43.70           15.40         15.40 (15.40)         14.00         17.00         17.00 (17.00)         1.90           15.40         15.40 (15.40)         13.70         17.00         17.00 (17.00)         1.70           7.50         7.50 (7.50)         0.80         8.50         8.50 (8.50)         0.90           36.00         36.00 (36.00)         24.00         40.00         40.00 (40.00)         15.00           7.50         7.50 (7.50)         6.00         8.50         8.50 (8.50)         6.00           36.00         36.00 (36.00)         32.00         40.00         40.00 (40.00)         23.00           36.00         36.00 (36.00)         32.00         27.00 (27.00)	TOTAL         HEATING         V - Ø - Hz           RATED         CORRECTED         REQUIRED         RATED         CORRECTED         REQUIRED         No. 13.50         13.50         13.10         208/230 - 1 - 60           7.50         7.50         7.50         1.10         8.50         8.50 (8.50)         1.20         208/230 - 1 - 60           7.50         7.50 (7.50)         1.10         8.50         8.50 (8.50)         1.20         208/230 - 1 - 60           7.50         7.50 (7.50)         1.10         8.50         8.50 (8.50)         1.20         208/230 - 1 - 60           72.00         72.00 (72.00)         37.20         81.00         81.00 (81.00)         43.70         208/230 - 1 - 60           15.40         15.40 (15.40)         14.00         17.00         17.00 (17.00)         1.90         208/230 - 1 - 60           15.40         15.40 (15.40)         13.70         17.00         17.00 (17.00)         1.70         208/230 - 1 - 60           7.50         7.50 (7.50)         0.80         8.50         8.50         0.90         208/230 - 1 - 60           36.00         36.00 (36.00)         24.00         40.00         40.00         40.00         208/230 - 1 - 60           7.50         7.50 (	TOTAL         HEATING         V - Ø - Hz         FLA           RATED         CORRECTED         REQUIRED         RATED         CORRECTED         REQUIRED         RATED         CORRECTED         REQUIRED         13.50         13.50         13.10         208/230 - 1 - 60         0.4           7.50         7.50 (7.50)         1.10         8.50         8.50 (8.50)         1.20         208/230 - 1 - 60         0.4           7.50         7.50 (7.50)         1.10         8.50         8.50 (8.50)         1.20         208/230 - 1 - 60         0.4           7.50         7.50 (7.50)         1.10         8.50         8.50 (8.50)         1.20         208/230 - 1 - 60         0.4           72.00         72.00 (72.00)         37.20         81.00         81.00 (81.00)         43.70         208/230 - 1 - 60         0.4           15.40         15.40 (15.40)         14.00         17.00         17.00 (17.00)         1.70         208/230 - 1 - 60         0.5           7.50         7.50 (7.50)         0.80         8.50         8.50 (8.50)         0.90         208/230 - 1 - 60         0.4           36.00         36.00 (36.00)         24.00         40.00         40.00 (40.00)         15.00         208/230 - 1 - 60         0.4	TOTAL         HEATING         V - Ø - Hz         FLA         MCA           RATED         CORRECTED         REQUIRED         RATED         CORRECTED         REQUIRED         RATED         CORRECTED         REQUIRED         No.4         0.5           12.00         12.00 (12.00)         9.20         13.50         13.50 (13.50)         13.10         208/230 - 1 - 60         0.4         0.5           7.50         7.50 (7.50)         1.10         8.50         8.50 (8.50)         1.20         208/230 - 1 - 60         0.4         0.5           7.50         7.50 (7.50)         1.10         8.50         8.50 (8.50)         1.20         208/230 - 1 - 60         0.4         0.5           7.50         72.00 (72.00)         37.20         81.00         81.00 (81.00)         43.70         208/230 - 1 - 60         0.4         0.5           15.40         15.40 (15.40)         14.00         17.00         17.00 (17.00)         1.90         208/230 - 1 - 60         0.4         0.5           15.40         15.40 (15.40)         13.70         17.00         17.00         1.90         208/230 - 1 - 60         0.4         0.5           36.00         36.00 (36.00)         24.00         40.00         40.00 (40.00) <td< td=""><td>TOTAL         HEATING         V - Ø - Hz         FLA         MCA         MOCP           12.00         12.00 (12.00)         9.20         13.50         13.50 (13.50)         13.10         208/230 - 1 - 60         0.4         0.5         15           7.50         7.50 (7.50)         1.10         8.50         8.50 (8.50)         1.20         208/230 - 1 - 60         0.4         0.5         15           7.50         7.50 (7.50)         1.10         8.50         8.50 (8.50)         1.20         208/230 - 1 - 60         0.4         0.5         15           7.50         7.50 (7.50)         1.10         8.50         8.50 (8.50)         1.20         208/230 - 1 - 60         0.4         0.5         15           7.50         7.50 (7.50)         1.10         8.50         8.50 (8.50)         1.20         208/230 - 1 - 60         0.4         0.5         15           7.50         7.50 (7.50)         37.20         81.00 (81.00)         43.70         208/230 - 1 - 60         0.4         0.5         15           15.40         15.40 (15.40)         13.70         17.00 (17.00)         1.70         208/230 - 1 - 60         0.4         0.5         15           7.50         7.50 (7.50)         0.80</td><td>Image: Problem in the section of the section</td><td>Image: First transformed by transformed by</td></td<>	TOTAL         HEATING         V - Ø - Hz         FLA         MCA         MOCP           12.00         12.00 (12.00)         9.20         13.50         13.50 (13.50)         13.10         208/230 - 1 - 60         0.4         0.5         15           7.50         7.50 (7.50)         1.10         8.50         8.50 (8.50)         1.20         208/230 - 1 - 60         0.4         0.5         15           7.50         7.50 (7.50)         1.10         8.50         8.50 (8.50)         1.20         208/230 - 1 - 60         0.4         0.5         15           7.50         7.50 (7.50)         1.10         8.50         8.50 (8.50)         1.20         208/230 - 1 - 60         0.4         0.5         15           7.50         7.50 (7.50)         1.10         8.50         8.50 (8.50)         1.20         208/230 - 1 - 60         0.4         0.5         15           7.50         7.50 (7.50)         37.20         81.00 (81.00)         43.70         208/230 - 1 - 60         0.4         0.5         15           15.40         15.40 (15.40)         13.70         17.00 (17.00)         1.70         208/230 - 1 - 60         0.4         0.5         15           7.50         7.50 (7.50)         0.80	Image: Problem in the section of the section	Image: First transformed by

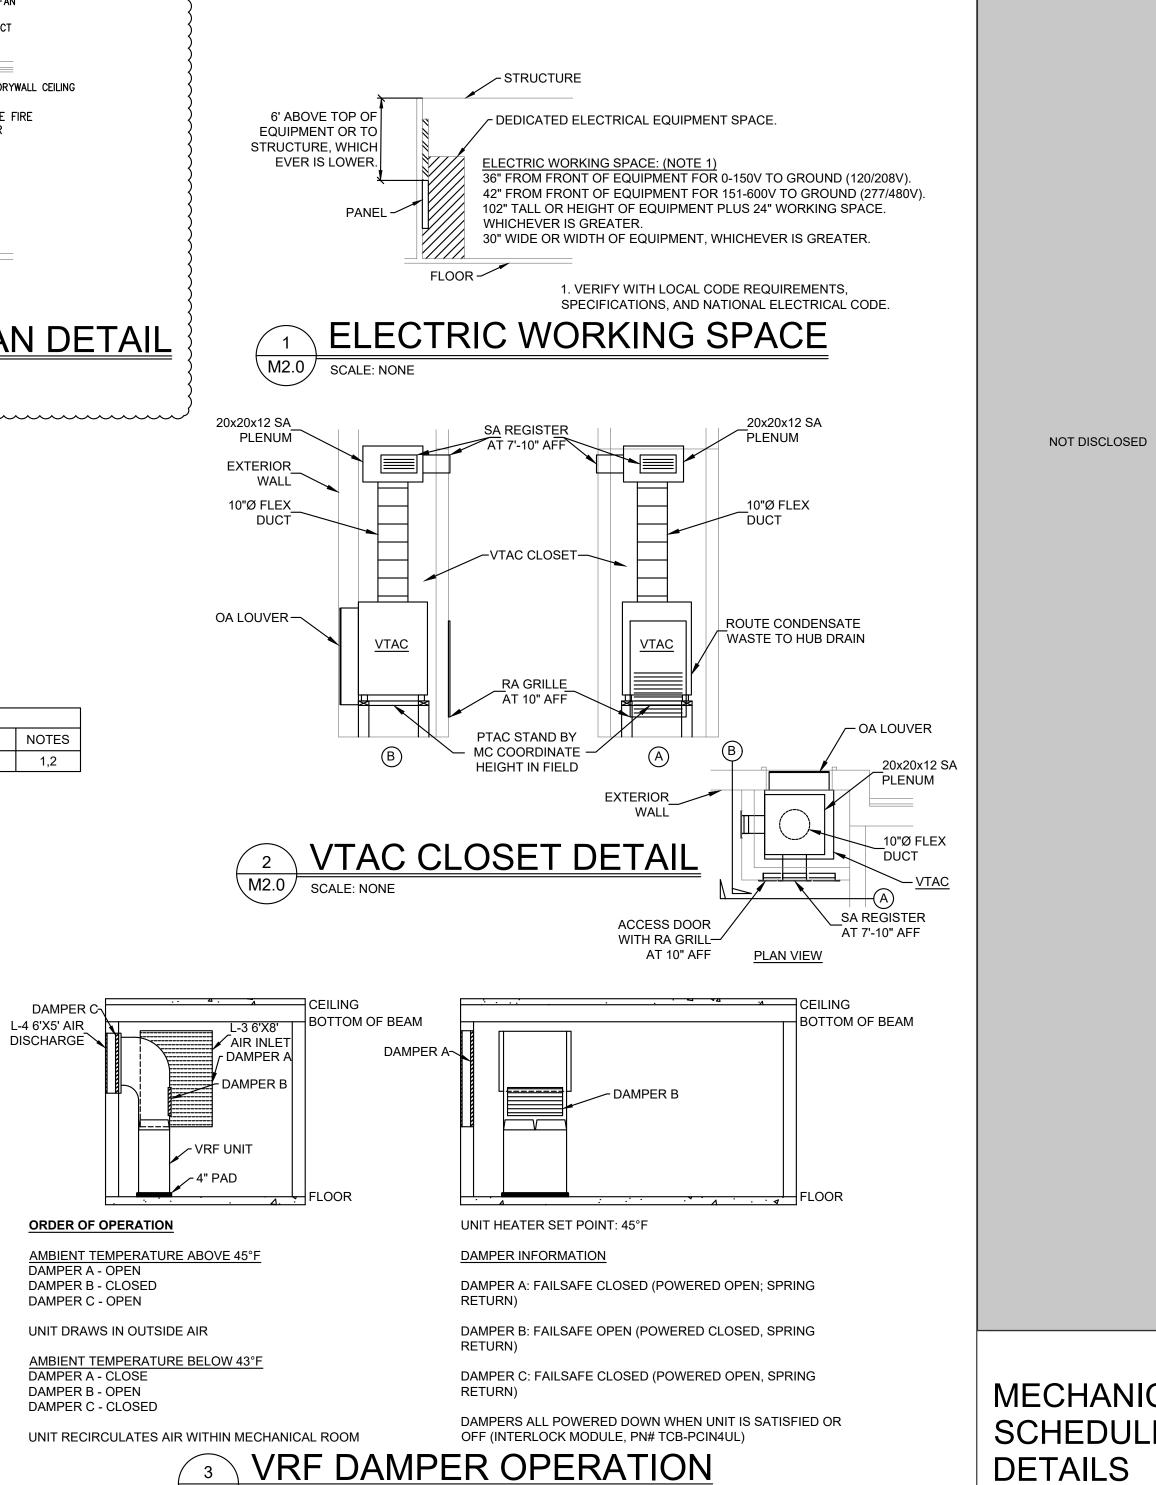






## MECHANICAL SCHEDULES & DETAILS

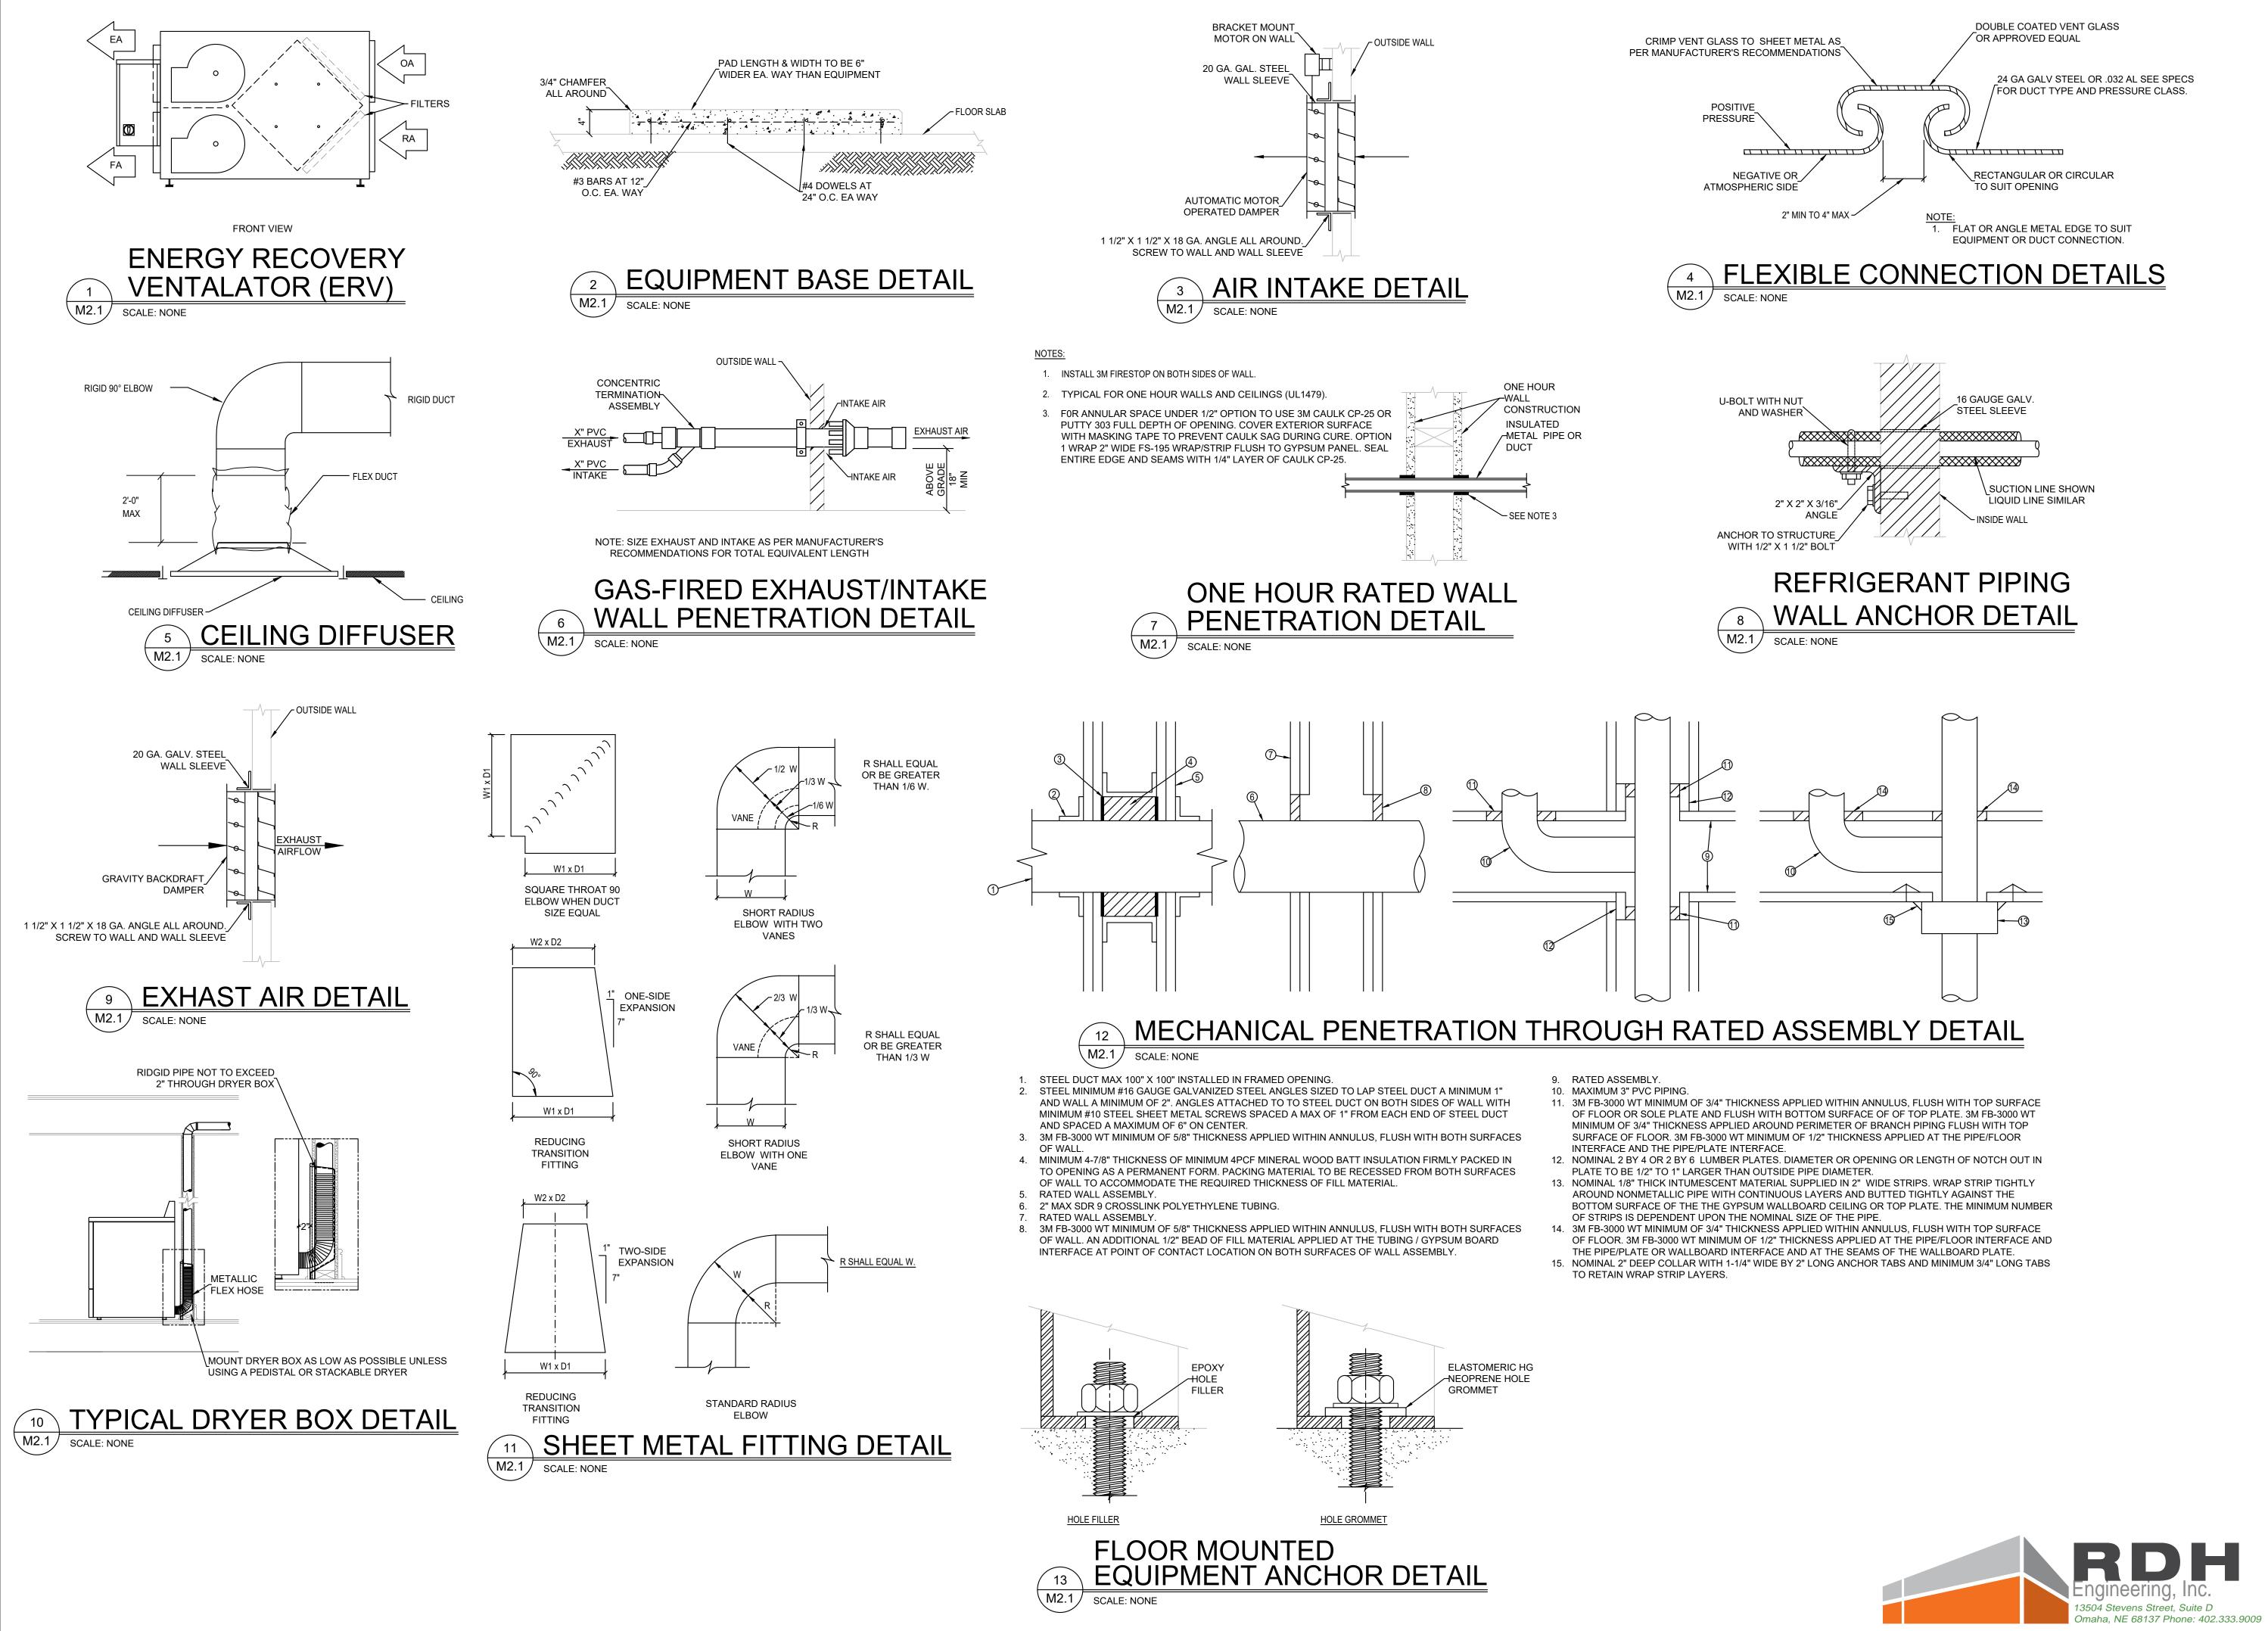

## MECHANICAL DETAILS (CONT.)

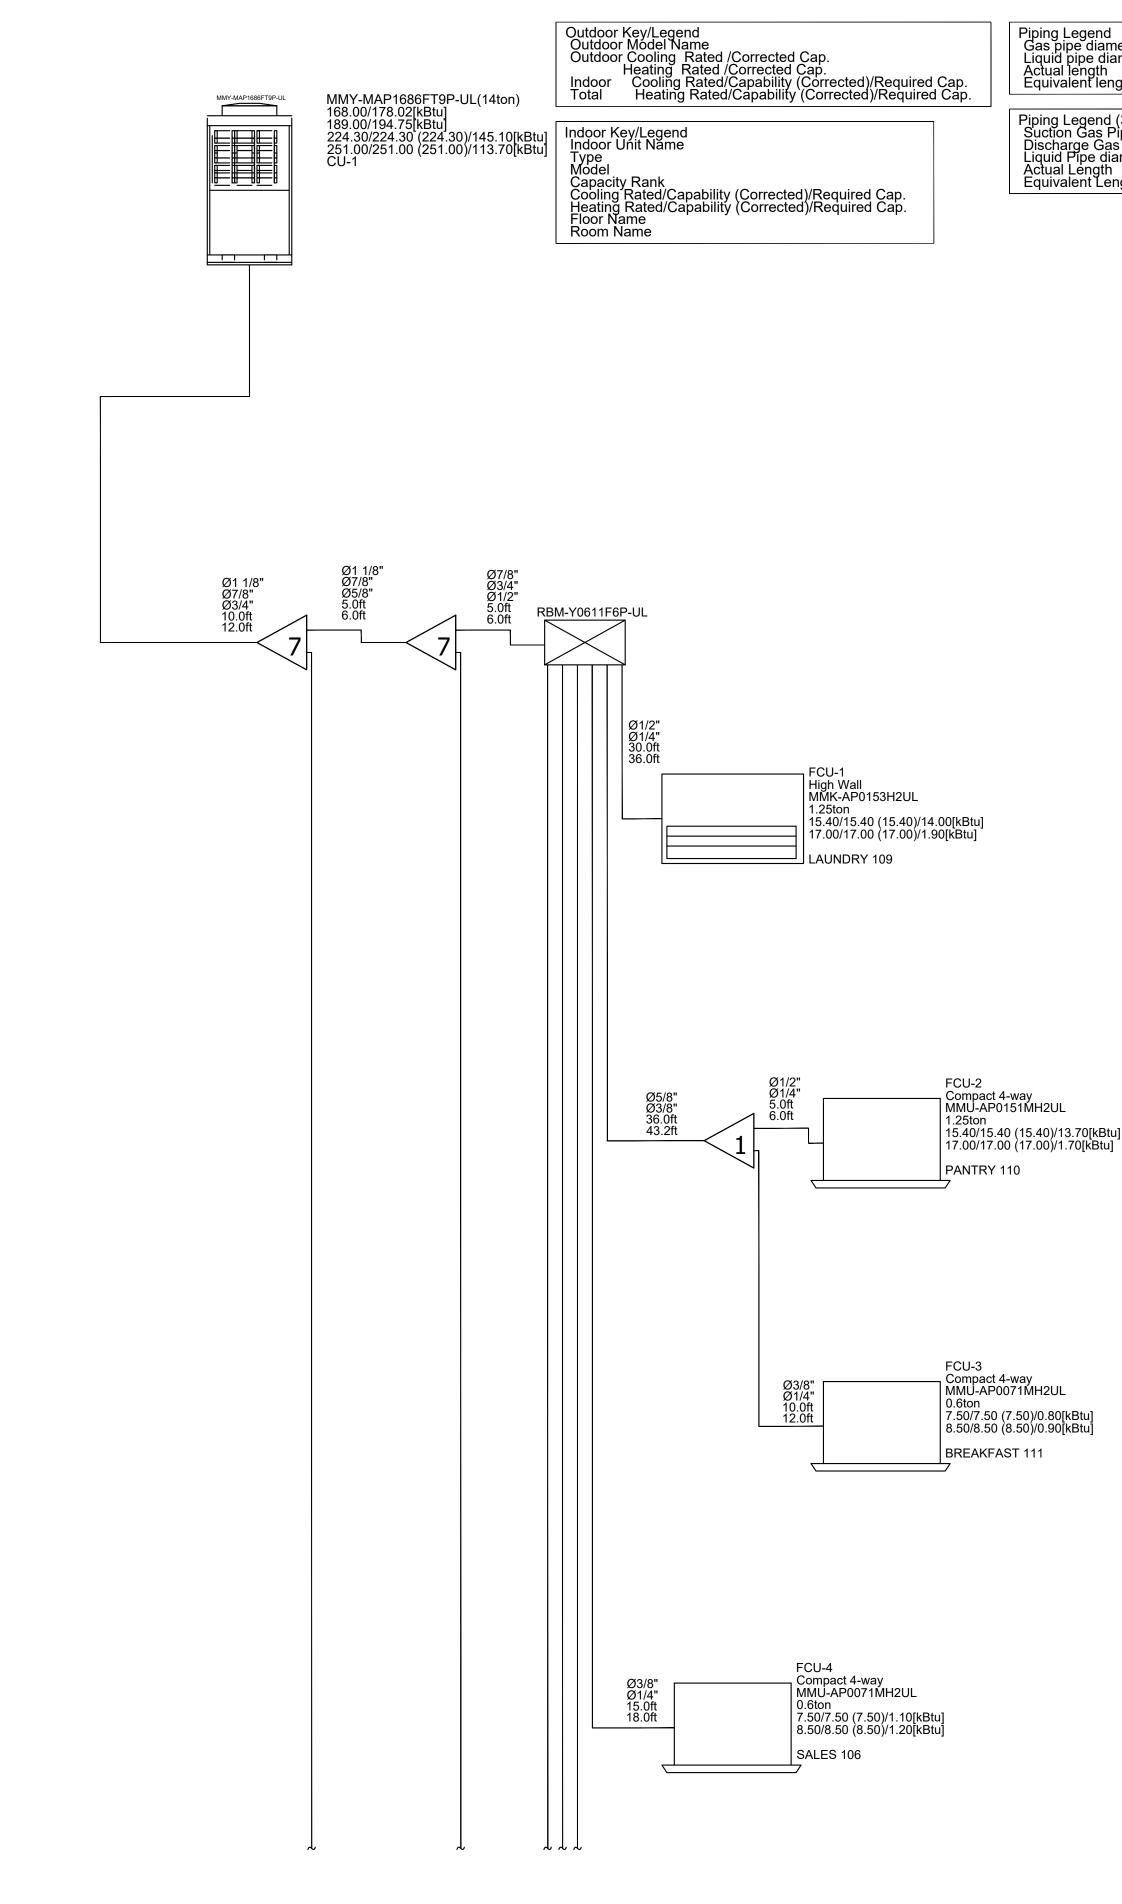

9/2016 8:54:10 AM

Piping Legend Gas pipe diameters Liquid pipe diameters Actual length Equivalent length

Piping Legend (3-pipe) Suction Gas Pipe diameters Discharge Gas Pipe diameters Liquid Pipe diameters Actual Length Equivalent Length

 $\leq 2$  $\triangleleft$  $\triangleleft$ <5 <6  $\triangleleft$ FCU-5 Compact 4-way MMU-AP0071MH2UL < 0.6ton 24.0ft 28.8ft 7.50/7.50 (7.50)/1.10[kBtu] 8.50/8.50 (8.50)/1.20[kBtu] WORK AREA 103 FCU-7 Compact 4-way MMU-AP0121MH2UL Ø3/8" Ø1/4" 15.0ft 18.0ft 1ton 12.00/12.00 (12.00)/9.20[kBtu] 13.50/13.50 (13.50)/13.10[kBtu] GEN MANAGER 105 FCU-12 High Static Duct MDD-AP0364H2UL Ø5/8" Ø3/8" 10.0ft 12.0ft 3ton 36.00/36.00 (36.00)/32.00[kBtu] 40.00/40.00 (40.00)/23.00[kBtu] FRESH AIR Ø5/8" Ø1/2" Ø3/8" 10.0ft 12.0ft Ø5/8" Ø1/2" Ø3/8" 0.0ft 0.0ft FCU-8 High Static Duct MMD-AP0364H2UL RBM-Y0383FUL 3ton 36.00/36.00 (36.00)/24.00[kBtu] 40.00/40.00 (40.00)/15.00[kBtu] FITNESS 114 FCU-9 Compact 4-way MMU-AP0071MH2UL 0.6ton 7.50/7.50 (7.50)/6.00[kBtu] 8.50/8.50 (8.50)/6.00[kBtu] Ø5/8" Ø1/2" Ø3/8" RBM-Y0383FUL Ø3/8" 10.0ft 12.0ft 12.0ft CONF ROOM 112 Compact 4-way MMU-AP0071MH2UL Ø3/8" Ø1/4" 10.0ft 12.0ft 0.6ton FCU-10 7.50/7.50 (7.50)/6.00[kBtu] 8.50/8.50 (8.50)/6.00[kBtu] CONF ROOM 112 Ø7/8" Ø3/4" Ø1/2" 5.0ft 6.0ft FCU-11 High Static Duct MMD-AP0726HP-UL 6ton 72.00/72.00 (72.00)/37.20[kBtu] 81.00/81.00 (81.00)/43.70[kBtu]

NAME

VRF

MMY-MAP1686FT9P-UL

CAPACITY

(MBH)

14

RBM-Y0963FUL

OBBY 101

QUAN	TITY				ACTUA	L PIPE I	LENGTH	(ft)									
OUTDOOR	INDOOR	DIV. (%)	ADE REF (lbs	RI	Ø1	/4"	Ø3/8	3"		Ø1/2"		Ø5/8"	Ø	3/4"	Ø7/8		Ø1-1/8"
1	11	134%	41.9	37	119 : 0	/0/119	170 : 0/8	84/86	70	: 20/35/15	9′	1 : 0/86/5	20 : 10	0/0/10	30 : 15/	15/0 1	5 : 0/15/0
					MCF C/	ALCULAI	ΓΙΟΝ										
	RBM-	BY55UL		RM	l Nu#	Desci	ription	AREA	(SF)	CEILING H (FT)	T	CALC VOL (CU FI			VOLUME FT)	сом	MENTS
$\triangleleft$	RBM-	BY105UL		1	.01 .03	WORI	BBY K AREA	255 172	2	12.5 9.0		3188 1548	7	•			CONNECT
$\bigtriangledown$	RBM-	BY205UL		1	.04	GEN M	RVER ANAGER	48 177	7	9.0 9.0		432 1593				SPA	ACES
4	RBM-	BY305UL		1	.06 .07 .08	ENG/I	iles Maint H/Elec	106 334 323	1	9.0 16.0 16.0		954 5344 5168					
\$	RBM-	BY55FUL		1 1	.09 .10	LAU PAN	NDRY NTRY	370 278	) 3	9.0 9.0		3330 2502	)	2384	.6154		
	RBM-	BY105FUL		1	. <u>11</u> . <u>12</u> 101	CONF	<u>kfast</u> Room R-Boh	299 713 258	3	9.0 12.75 11.0		2691 9090 2838	)				
	RBM-	BY205FUL		C	101 103 ECH	COR	R-FIT I MEZZ	879	)	<u>11.0</u> <u>11.0</u> 7.0		9669	)			LTD TO	FITNESS
											Г			1			
$\triangleleft$	RBM-	BY305FUL										PRODUC					QTY
											╞	OUTDOO INDOOR (			′-MAP168 1U-AP007		

INDOOR UNIT(S) MMU-AP0121MH2UL 1

INDOOR UNIT(S) MMU-AP0151MH2UL 1 INDOOR UNIT(S) MMK-AP0153H2UL 1 INDOOR UNIT(S) MMD-AP0364H2UL INDOOR UNIT(S) MMD-AP0726HP-UL ACCESSORIES RBC-UM11PG(W)-UL Y-JOINT(S) RBM-BY55FUL

RBM-BY205FUL 2

12

8

RBM-BY55UL

RBM-Y0383FUL

RBM-Y0963FUL

RBM-Y0611F6P-UL

RBC-AMS54E-UL

RBC-AMS51E-ES

R/C RBC-AS41UL 1

Y-JOINT(S)

Y-JOINT(S)

FS-UNIT

FS-UNIT

FS-UNIT

R/C


R/C

# FOR REFERENCE ONLY

**VRF PIPING** DIAGRAM





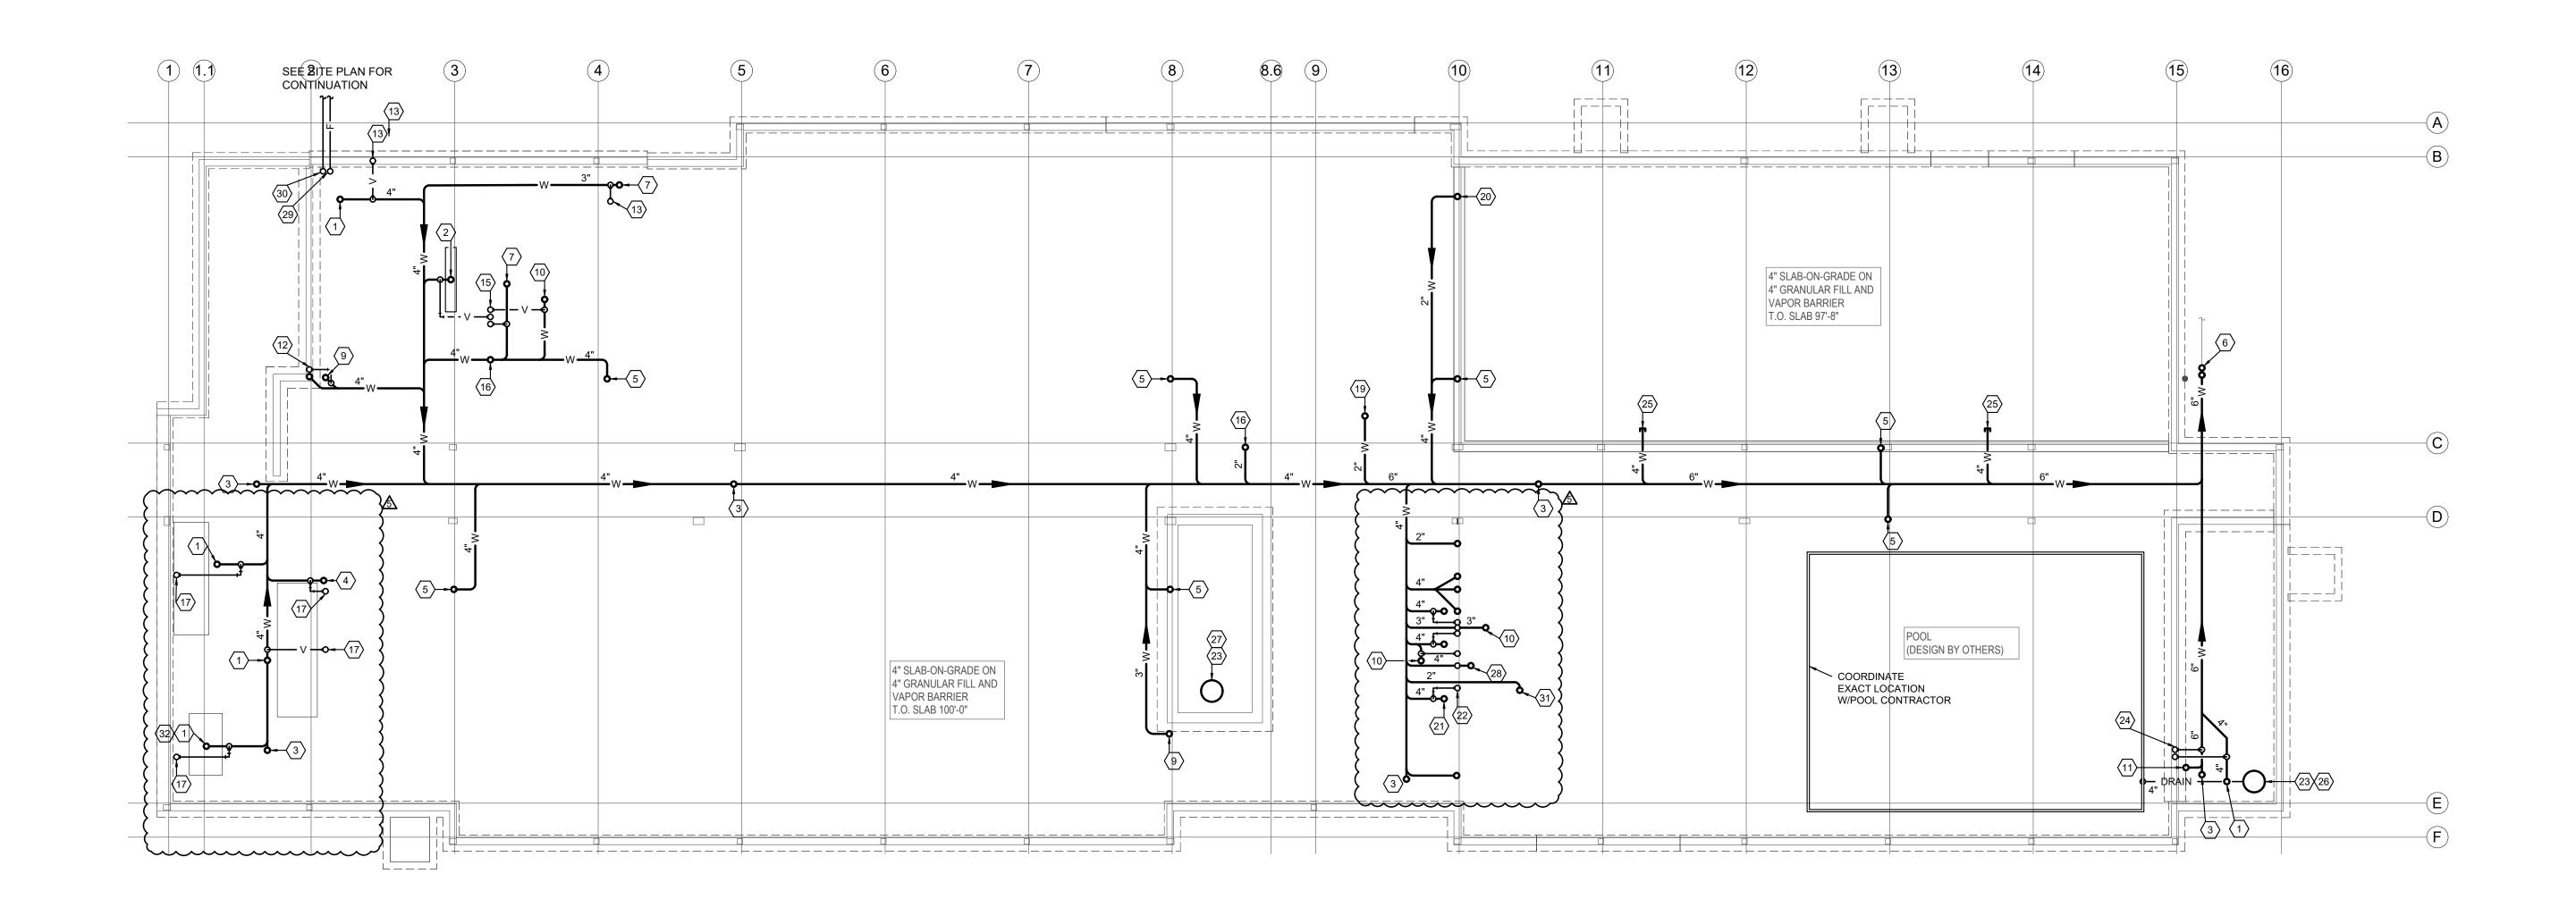



1 UNDERGROUND PLUMBING PLAN 1/8" = 1'-0"

### KEYED PLUMBING NOTES: 🐼

- 1. 4" W UP TO FD-2.
- 2. 4" W UP TO TD-2.
- 3. 4" W UP TO CO.
- 4. 4" W UP TO HD.
- 5. 4" W STACK UP.
- 6. 4" W UP TO DOUBLE CO.
- 7. 3" W UP TO FSK.
- 8. NOT USED.
- 9. 3" W STACK UP.
- 10. 3" W UP TO FD-1.
- 11. 6" W UP TO SWIMMING POOL DRAIN STANDPIPE. COORDINATE THE EXACT LOCATION WITH THE SWIMMING
- POOL CONTRACTOR.
- 12. 2" V UP, 4" W STACK UP.
- 13. 11/2" V UP.

#### {14. NOT USED. }

- 15. 1 1/2" V UP, 1 1/2" V UP, 1 1/2" V UP.
- 16. 2" W UP TO SK.
- 17. 2" V UP.
- 18. NOT USED.
- 19. 2" W UP TO EWC-1.
- 20. 2" W UP TO DRAIN BOX.
- 21. 4" W UP TO WC, 4" W UP TO WC, 4" W UP TO WC.
- 22. 2" W UP TO LAV, 2" W UP TO LAV, 4" W STACK UP, 2" W UP TO
- UR, 2" V UP, 1 1/2" V UP, 2" V UP, 1 1/2" V UP, 2" V UP, 2" V UP.
- 23. 24" X 48" FIBER SUMP BASIN.
- 24. 2" V UP, 2" V UP.



- 26. SUMP PUMP FOR POOL EQUIPMENT PROVIDED BY OTHER.
- 27. PROVIDE WITH STEEL GRATE SUITABLE FOR 150# LOAD AND 100 GPM FLOW RATE. SEE ELEVATOR SUMP PUMP DETAIL.
- 28. 4" W UP TO WC.
- 29. 6" FIRE SPRINKLER MAIN UP TO FLANGE.
- 30. 3" CW UP.
- 31. 2" WASTE UP TO EWC-2.
- 32. ROUTE FD UP THROUGH EQUIPMENT PAD. SLOPE CONCRETE PAD TO FD.






### UNDERGROUND PLUMBING PLAN

NOT DISCLOSED

Sheet No. | P1.0



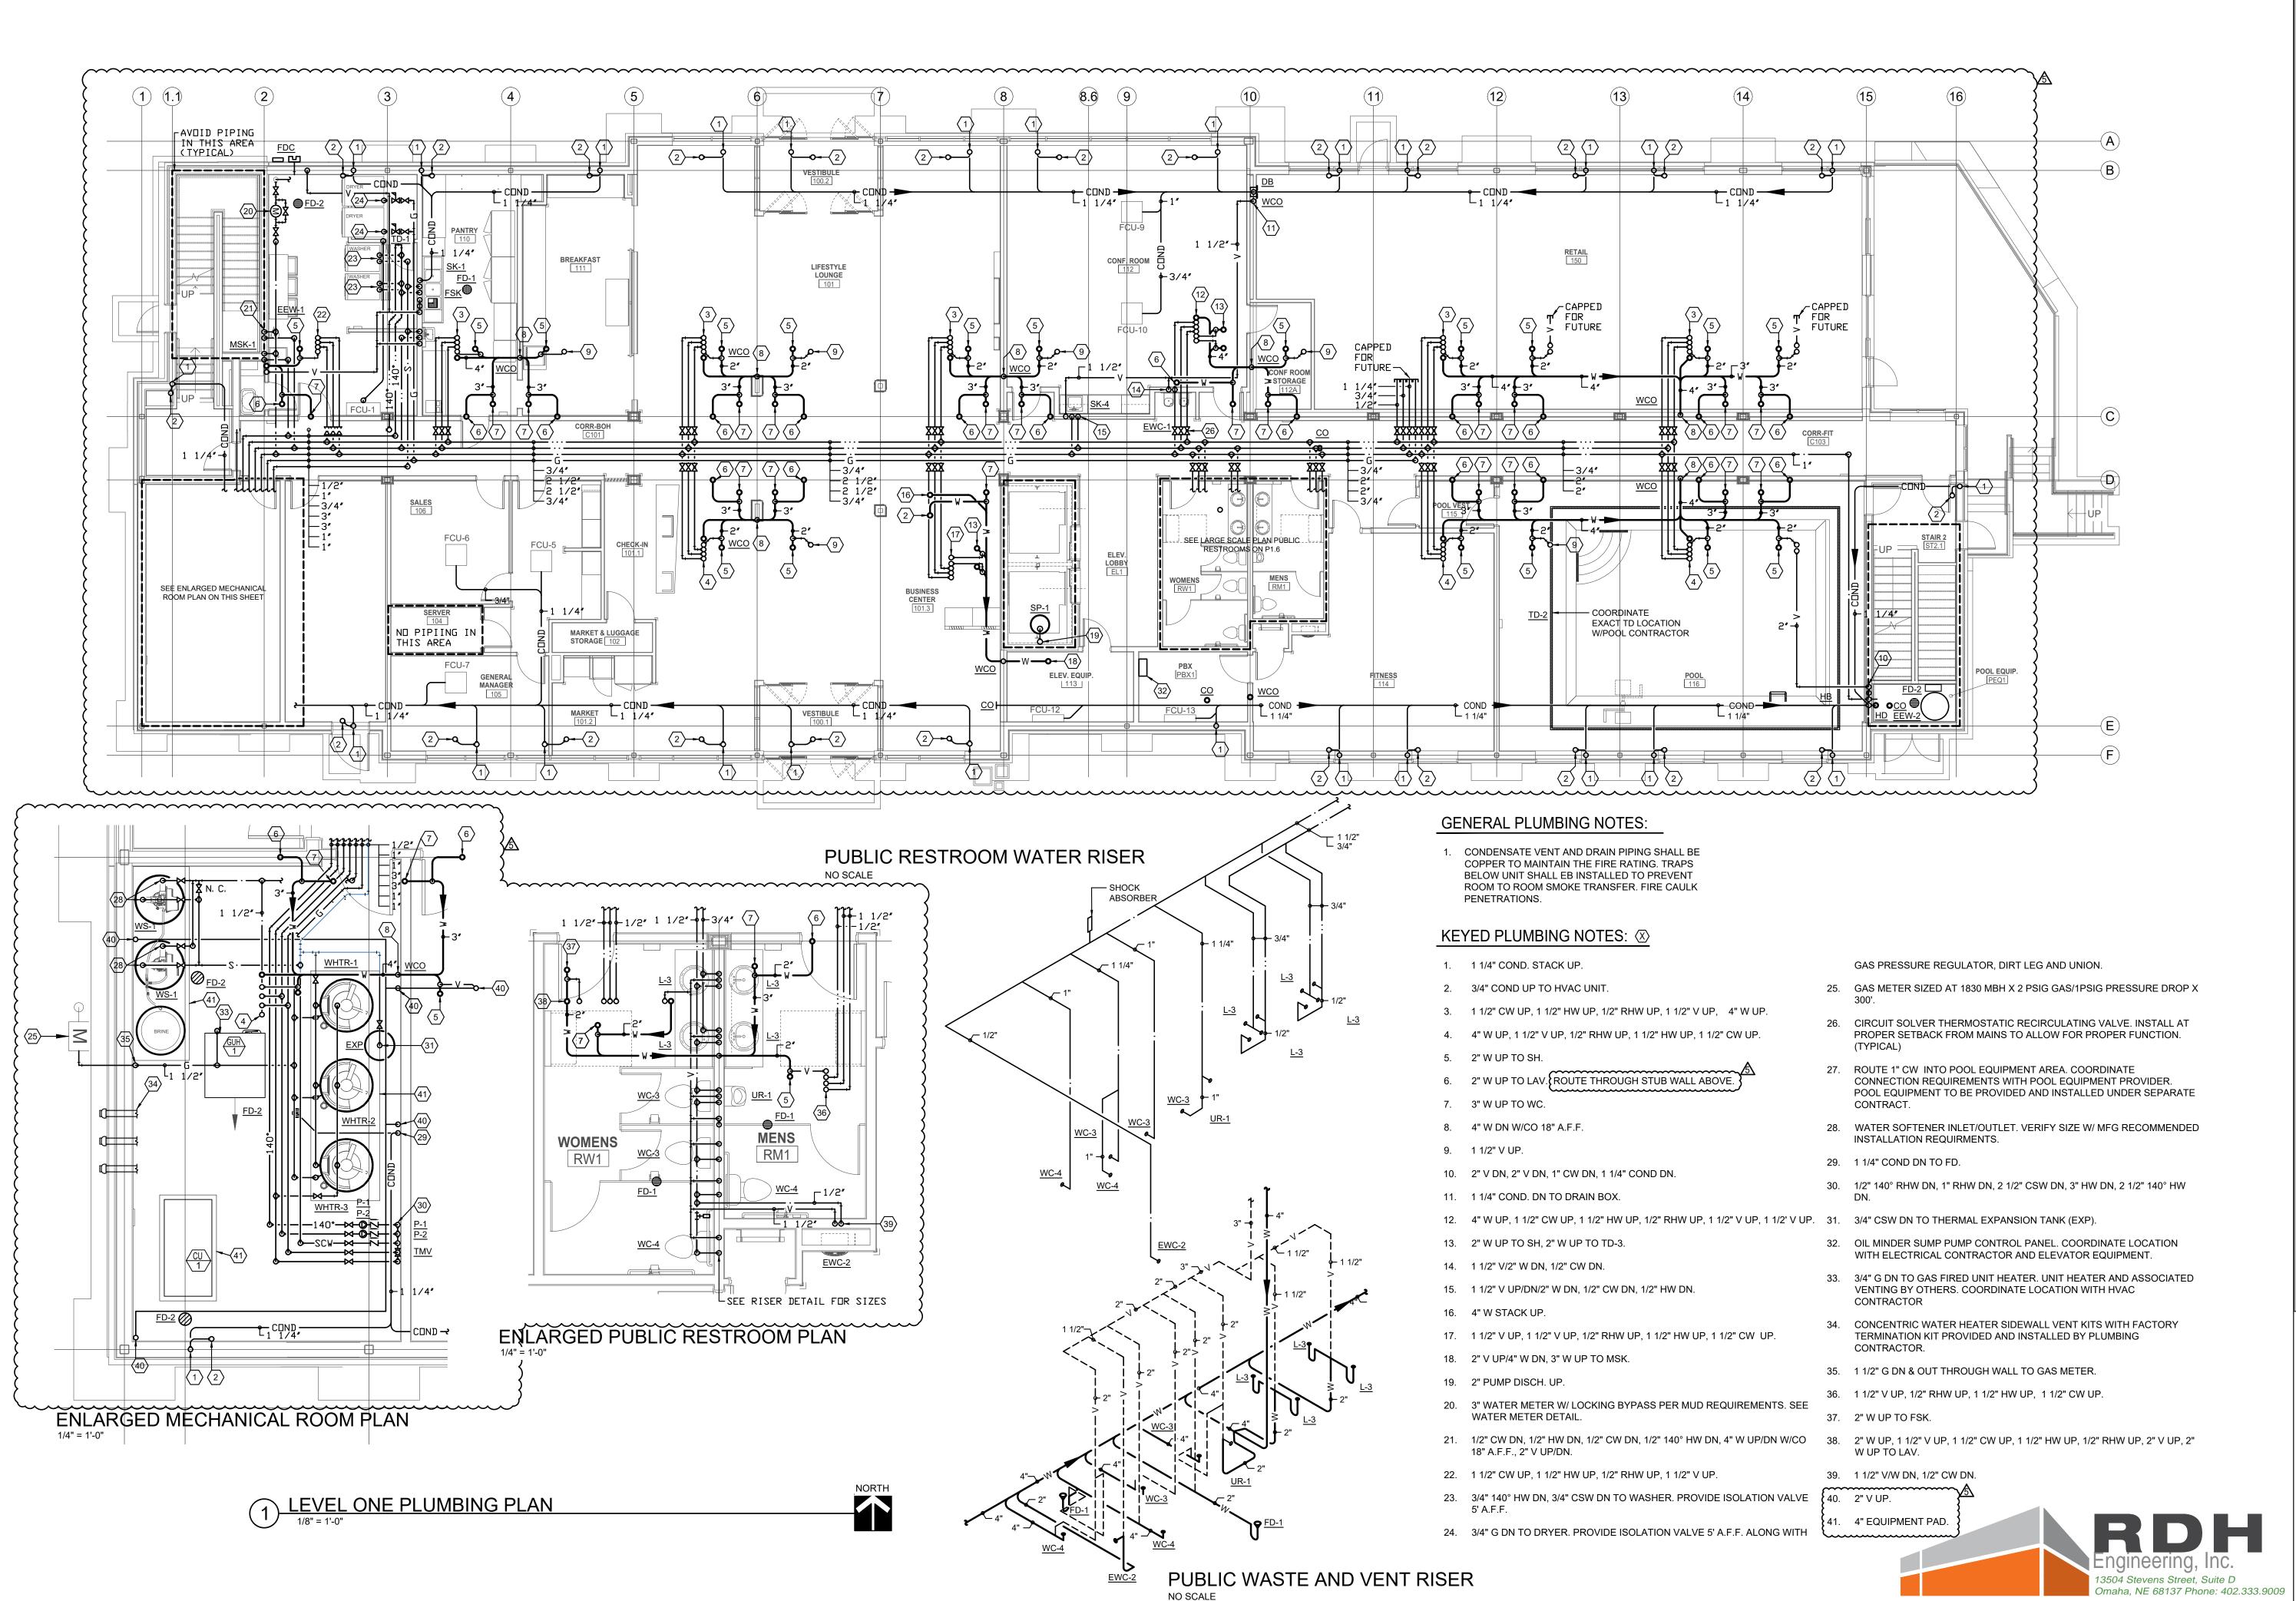


		GAS PRESSURE REGULATOR, DIRT LEG AND UNION.
	25.	GAS METER SIZED AT 1830 MBH X 2 PSIG GAS/1PSIG PRESSURE DROP X 300'.
·.	26.	CIRCUIT SOLVER THERMOSTATIC RECIRCULATING VALVE. INSTALL AT PROPER SETBACK FROM MAINS TO ALLOW FOR PROPER FUNCTION. (TYPICAL)
	27.	ROUTE 1" CW INTO POOL EQUIPMENT AREA. COORDINATE CONNECTION REQUIREMENTS WITH POOL EQUIPMENT PROVIDER. POOL EQUIPMENT TO BE PROVIDED AND INSTALLED UNDER SEPARATE CONTRACT.
	28.	WATER SOFTENER INLET/OUTLET. VERIFY SIZE W/ MFG RECOMMENDED INSTALLATION REQUIRMENTS.
	29.	1 1/4" COND DN TO FD.
	30.	1/2" 140° RHW DN, 1" RHW DN, 2 1/2" CSW DN, 3" HW DN, 2 1/2" 140° HW DN.
1 1/2' V UP.	31.	3/4" CSW DN TO THERMAL EXPANSION TANK (EXP).
	32.	OIL MINDER SUMP PUMP CONTROL PANEL. COORDINATE LOCATION WITH ELECTRICAL CONTRACTOR AND ELEVATOR EQUIPMENT.
	33.	3/4" G DN TO GAS FIRED UNIT HEATER. UNIT HEATER AND ASSOCIATED VENTING BY OTHERS. COORDINATE LOCATION WITH HVAC CONTRACTOR
JP.	34.	CONCENTRIC WATER HEATER SIDEWALL VENT KITS WITH FACTORY TERMINATION KIT PROVIDED AND INSTALLED BY PLUMBING CONTRACTOR.
	35.	1 1/2" G DN & OUT THROUGH WALL TO GAS METER.
NTS. SEE	36.	1 1/2" V UP, 1/2" RHW UP, 1 1/2" HW UP, 1 1/2" CW UP.
INTS. SEE	37.	2" W UP TO FSK.
DN W/CO	38.	2" W UP, 1 1/2" V UP, 1 1/2" CW UP, 1 1/2" HW UP, 1/2" RHW UP, 2" V UP, 2" W UP TO LAV.
	39.	1 1/2" V/W DN, 1/2" CW DN.
ON VALVE	40.	2" V UP.
NG WITH	41.	4" EQUIPMENT PAD.
		Engineering, Inc.

### LEVEL ONE PLUMBING PLAN

 
NOT DISCLOSED


Sheet No. | P1.1



## 1 LEVEL TWO PLUMBING PLAN

### TYPICAL CONDENSATE DRAIN RISER

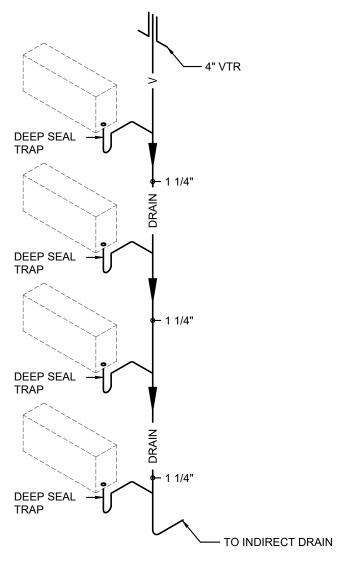

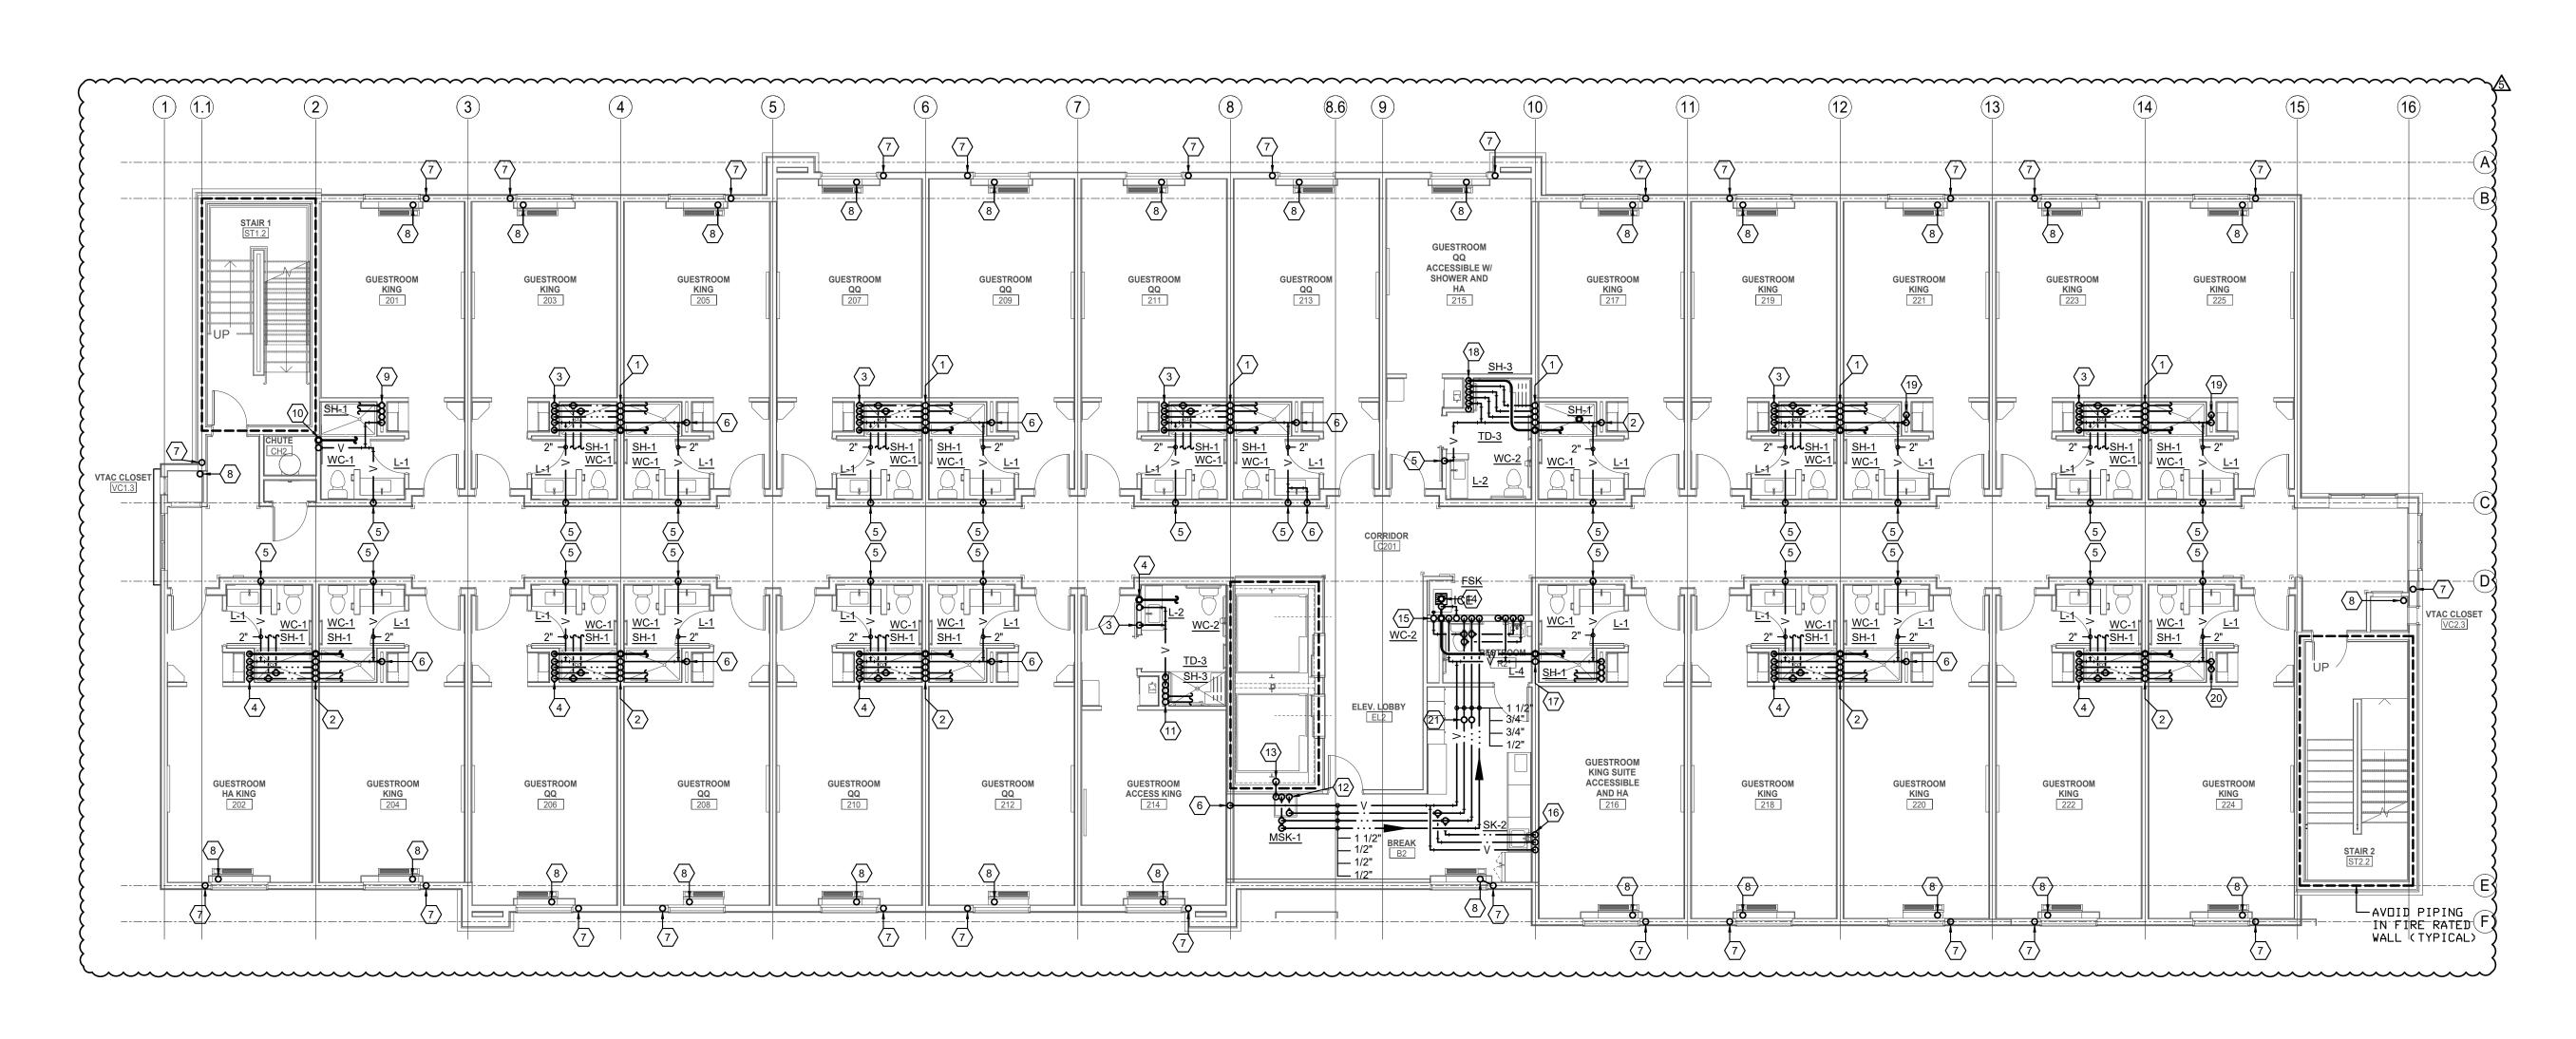

### GENERAL PLUMBING NOTES:

1. CONDENSATE VENT AND DRAIN PIPING SHALL BE COPPER TO MAINTAIN THE FIRE RATING. TRAPS BELOW UNIT SHALL EB INSTALLED TO PREVENT ROOM TO ROOM SMOKE TRANSFER. FIRE CAULK PENETRATIONS.

### KEYED PLUMBING NOTES: 🐼

- 1. 1 1/2" CW UP, 1 1/2" HW UP, 1/2" RHW UP, 3" V UP/2" V 12. 2" PUMP DISCH. DN TO MSK, 1/2" HW DN, 1/2" CW DN. DN, 4" W UP.
- 2. 4" W UP, 3" V UP/2" V DN, 1/2" RHW UP, 1 1/2" HW UP, 1 1/2" CW UP.
- 3. 1 1/2" CW DN, 1 1/2" HW DN, 1/2" RHW DN, 1 1/2" V DN, 15. 3/4" CW UP/1/2" DN, 2" W UP/DN, 1 1/2" V DN, 1 1/2" V 4" W DN.
- 4. 4" W DN, 1 1/2" V DN, 1/2" RHW DN, 1 1/2" HW DN, 1 1/2" CW DN.
- 5. 2" V/W DN.
- 6. 11/2" V DN.
- 7. 1 1/4" COND UP/DN.
- 8. 1 1/4" COND UP TO HD.
- 9. 1 1/4" CW UP, 1 1/4" HW UP, 1/2" RHW UP, 1 1/2" V DN.
- 10. 4" W UP/DN, 2" V UP/DN.
- 11. 1 1/2" V DN, 1 1/2" V DN, 1 1/2" CW UP/DN, 1 1/2" HW UP/DN, 1/2" RHW UP/DN.

- 13. 2" PUMP DISCH. DN TO SP-1.
- 14. 2" W UP TO FSK.
- UP, 1/2" CW DN, 3/4" HW DN, 1/2" RHW DN, 2" V DN, 2" V/W DN, DN, 1/2" HW DN, 1/2" CW DN.
- 16. 1/2" HW DN, 1/2" CW DN, 1 1/2" V/2" W DN.
- 17. 4" W UP, 2" V UP.
- 18. 4" W DN, 1 1/2" CW DN, 1 1/2" HW DN, 1/2" RHW DN, 1 1/2" V DN, 1 1/2" V DN.
- 19. 2" V DN, 2"/1 1/2" V DN.
- 20. 2"/1 1/2" V DN, 2" V DN.
- 21. 3/4" HW & CW UP.




NOT DISCLOSED

LEVEL TWO PLUMBING PLAN





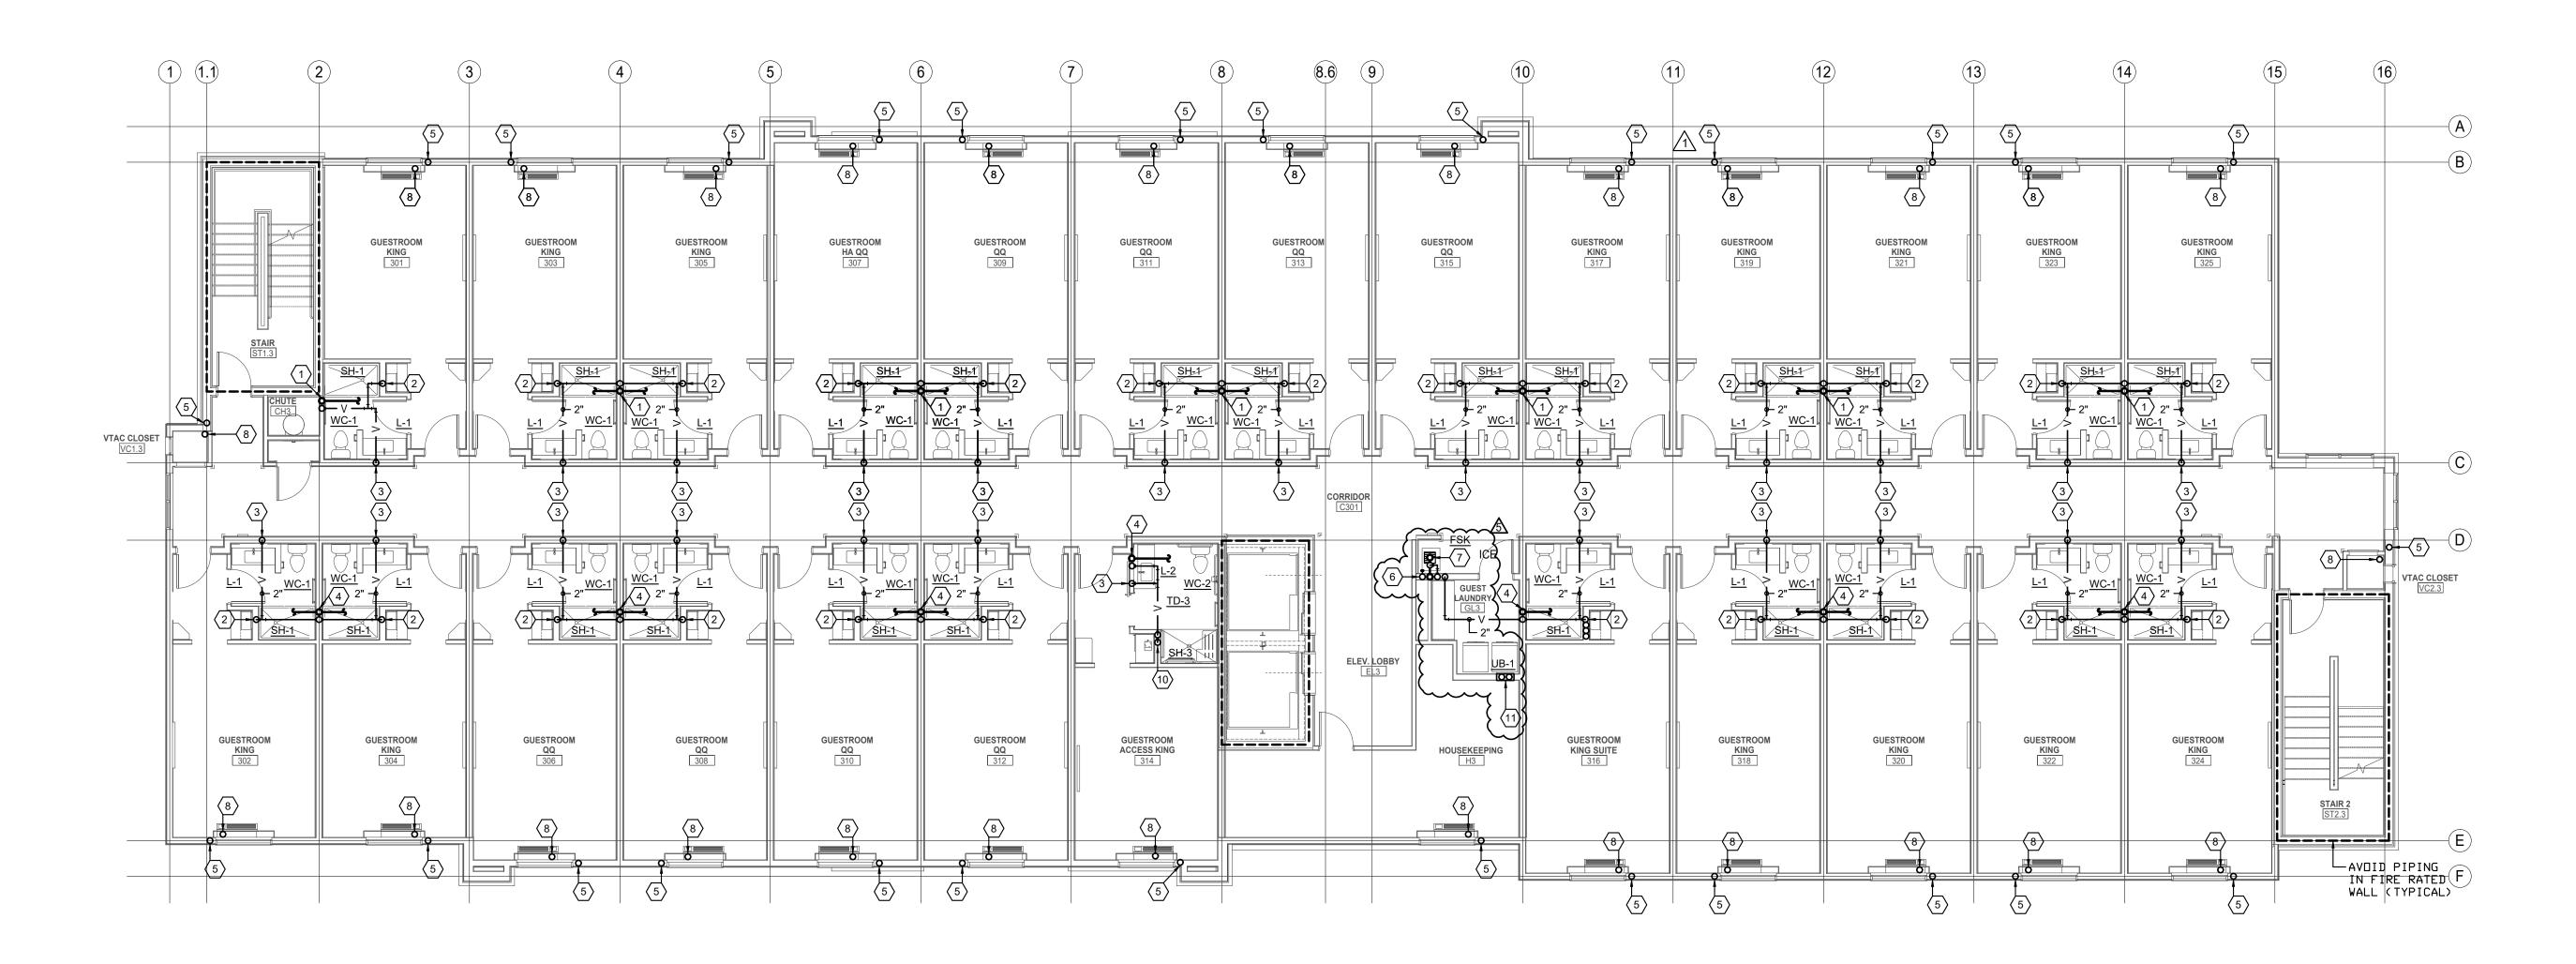



1 LEVEL THREE PLUMBING PLAN

#### GENERAL PLUMBING NOTES:

NORTH

1. CONDENSATE VENT AND DRAIN PIPING SHALL BE COPPER TO MAINTAIN THE FIRE RATING. TRAPS BELOW UNIT SHALL EB INSTALLED TO PREVENT ROOM TO ROOM SMOKE TRANSFER. FIRE CAULK PENETRATIONS.

### KEYED PLUMBING NOTES: 🐼


- 1. 3" V UP/DN, 4" W UP/DN.
- 2. 1 1/2" V DN.
- 3. 2" V/W DN.
- 4. 4" W UP/DN, 3" V UP/DN.
- 5. 1 1/4" CONDENSATE DRAIN UP/DN.
- 6. 3/4" CW UP/DN, 2" W UP/DN, 1 1/2" V UP, 1 1/2" V DN.
- 7. 2" W UP TO FSK.
- 8. 1 1/4" CONDENSATE HUB DRAIN.
- 9. 2" V DN.
- 10. 10. 1 1/2" V DN, 1 1/2" V DN.
- 11. 3/4" HW UP, 3/4" CW UP TO WASHER. PROVIDE ISOLATION VALVE 5' A.F.F.

NOT DISCLOSED

### LEVEL THREE PLUMBING PLAN





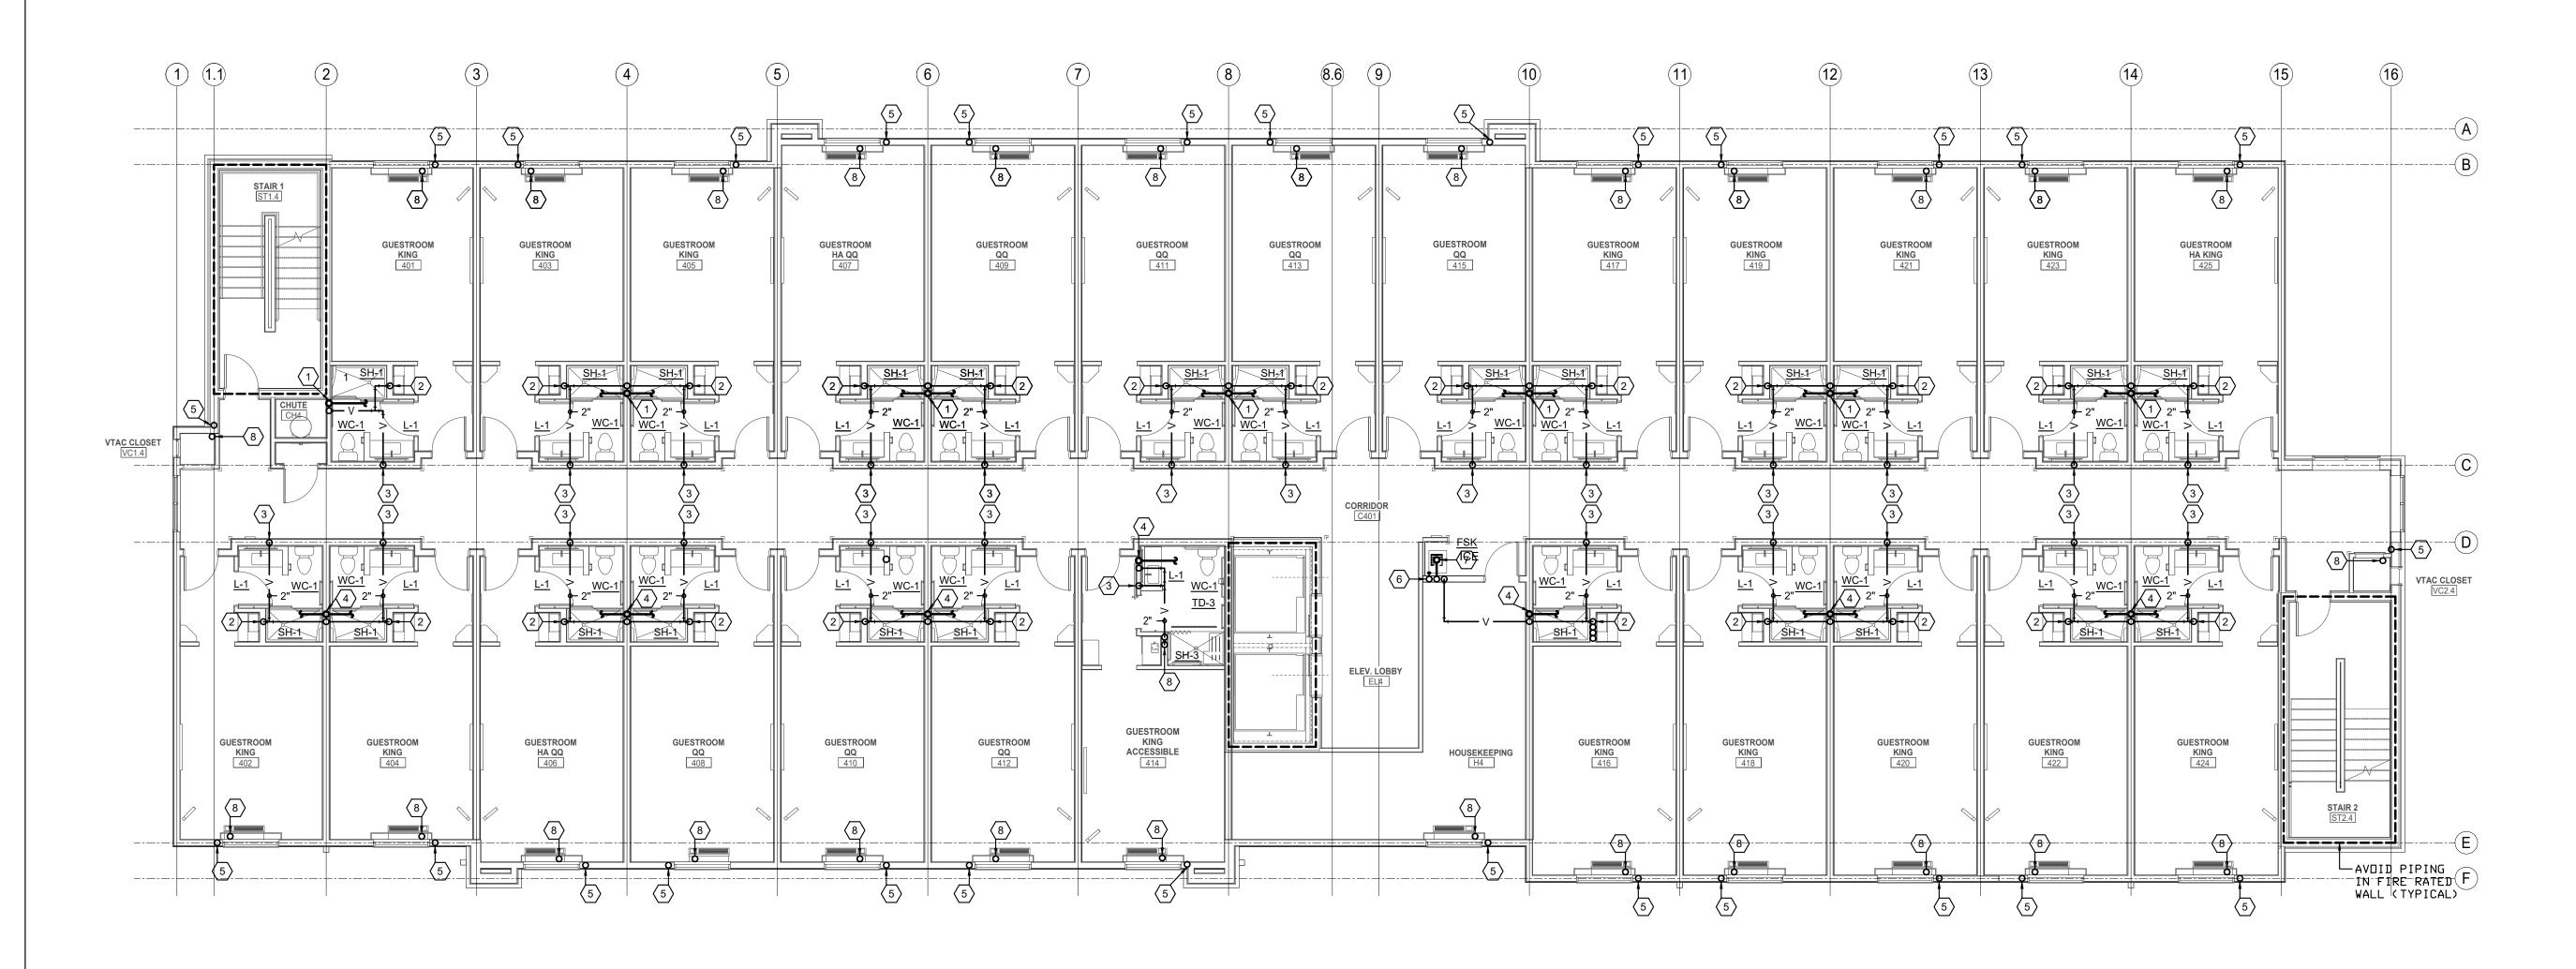



### GENERAL PLUMBING NOTES:

NORTH

1. CONDENSATE VENT AND DRAIN PIPING SHALL BE COPPER TO MAINTAIN THE FIRE RATING. TRAPS BELOW UNIT SHALL EB INSTALLED TO PREVENT ROOM TO ROOM SMOKE TRANSFER. FIRE CAULK PENETRATIONS.

### KEYED PLUMBING NOTES: 🗵


- 1. 3" V UP/DN, 3" W UP/DN. SEE TYPICAL ROOM RISERS.
- 2. 1 1/2" V DN.
- 3. 2" V/W DN.
- 4. 3" W DN, 3" V UP/DN.
- 5. 1 1/4" CONDENSATE DRAIN UP/DN.
- 6. 3/4" CW UP/DN, 1 1/2" W UP/2" W DN, 1 1 /2" V DN.
- 7. 2" W UP TO FSK.
- 8. 1 1/4" CONDENSATE HUB DRAIN.
- 9. 1 1/2" V DN, 1 1/2" V DN.

NOT DISCLOSED

LEVEL FOUR PLUMBING PLAN





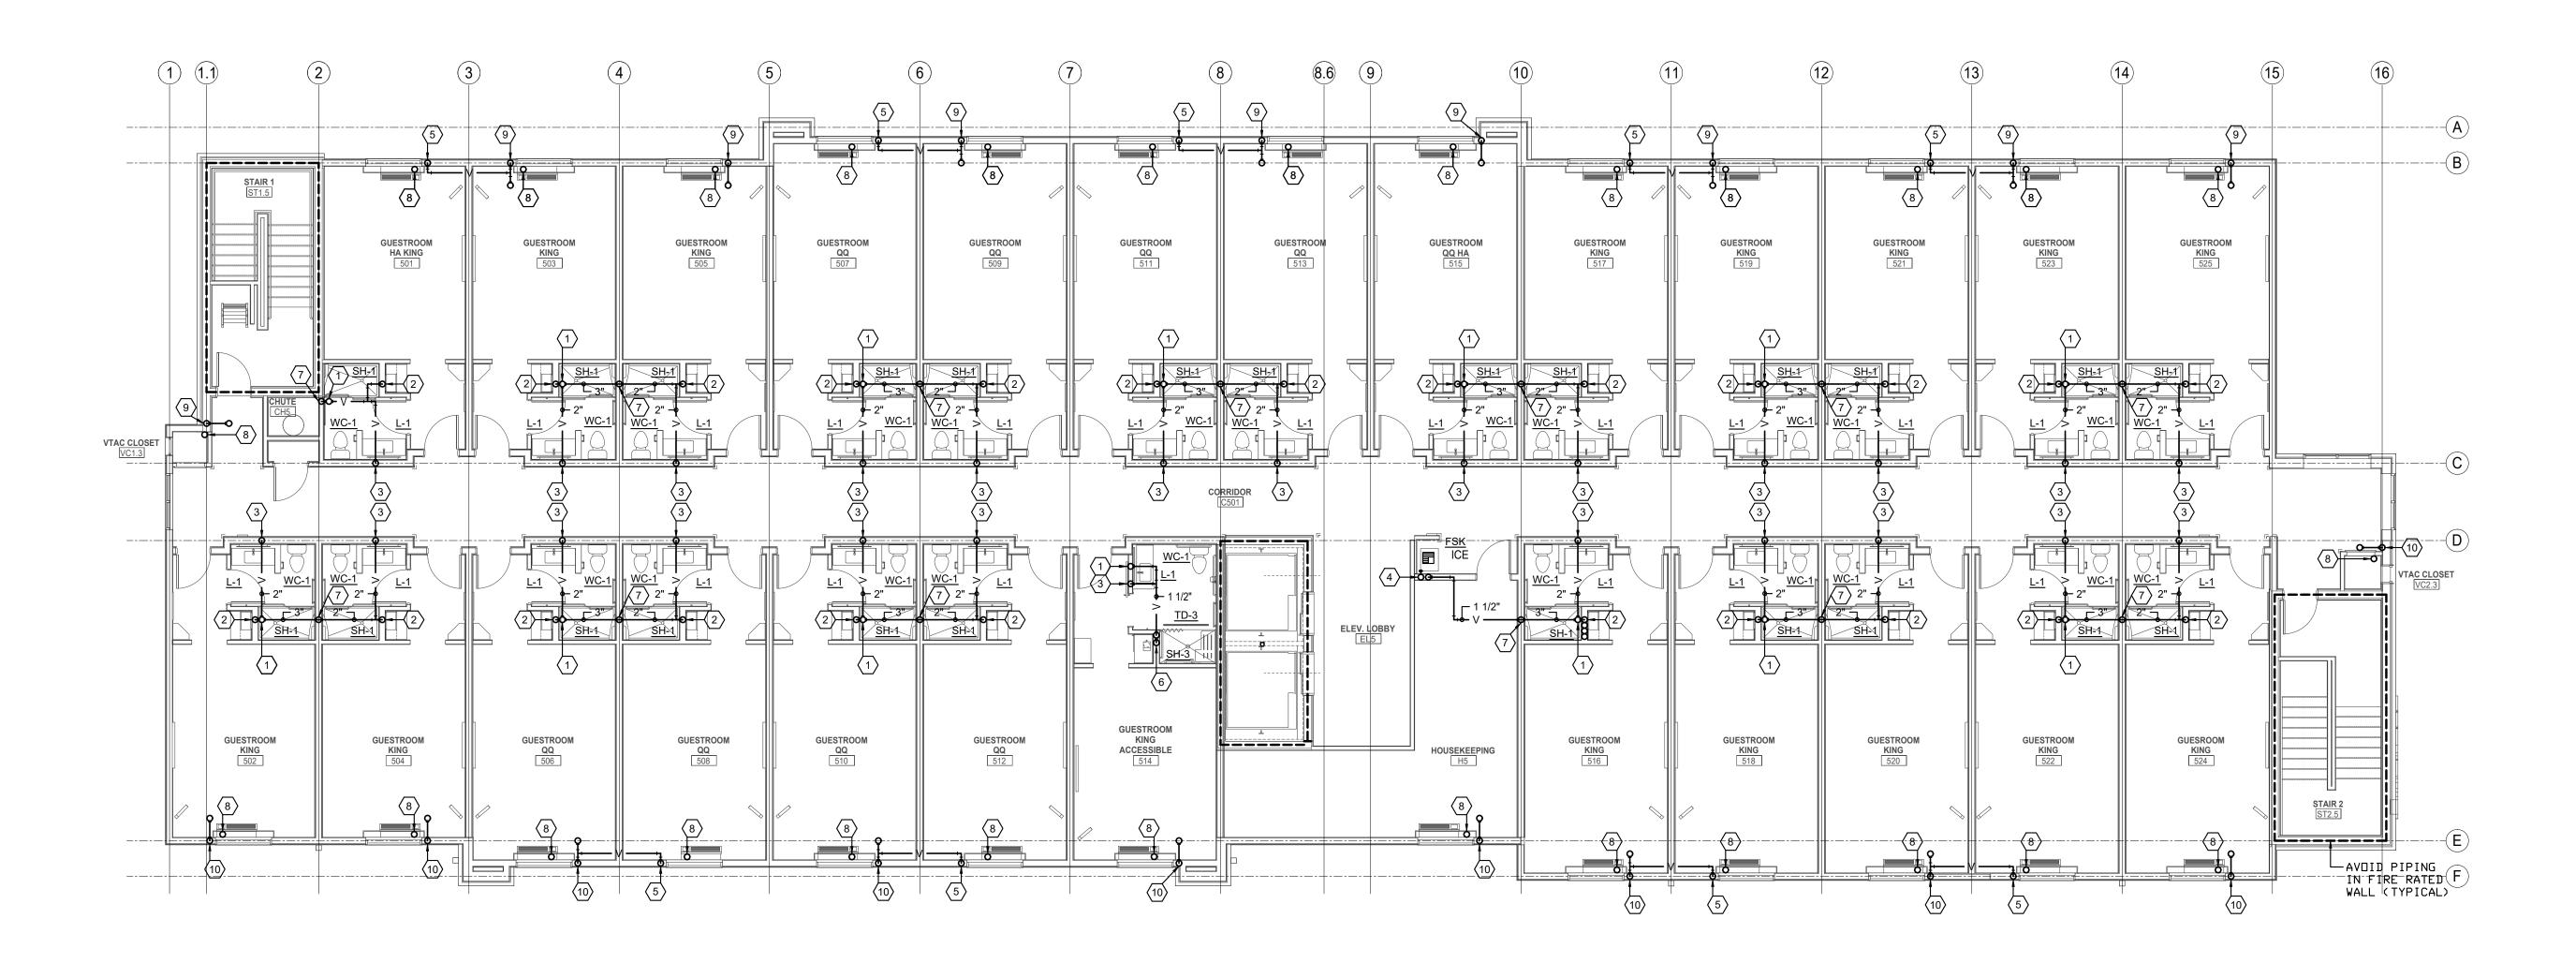



1 LEVEL FIVE PLUMBING PLAN

### GENERAL PLUMBING NOTES:

NORTH

1. CONDENSATE VENT AND DRAIN PIPING SHALL BE COPPER TO MAINTAIN THE FIRE RATING. TRAPS BELOW UNIT SHALL EB INSTALLED TO PREVENT ROOM TO ROOM SMOKE TRANSFER. FIRE CAULK PENETRATIONS.

### KEYED PLUMBING NOTES: 🐼

- 1. 3" V UP (4" VTR).
- 2. 1 1/2" V DN.
- 3. 2" V/W DN.
- 4. 3/4" CW DN, 1 1/2" V DN.
- 5. 1 1/2" V DN.
- 6. 11/2" V DN, 11/2" V DN.
- 7. 3" V DN.
- 8. 1 1/4" HD FOR CONDENSATE.
- 9. 11/2" V DN, 11/2" V UP (4" VTR).
- 10. 1 1/2" V UP (4" VTR), 1 1/2" V DN.


NOT DISCLOSED

LEVEL FIVE PLUMBING PLAN








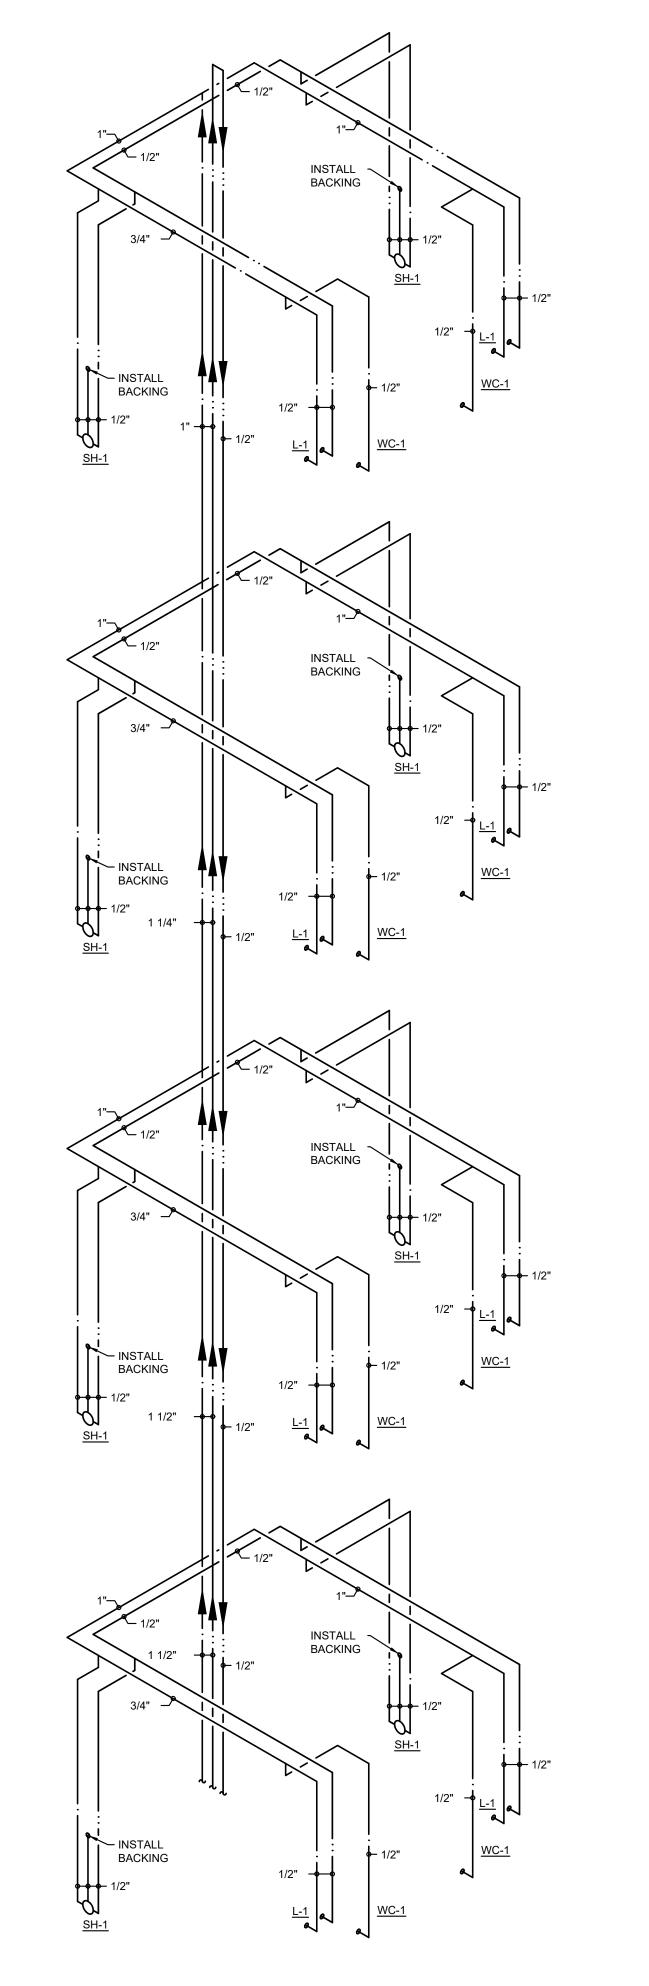



**TYPICAL WASTE & VENT RISER** 

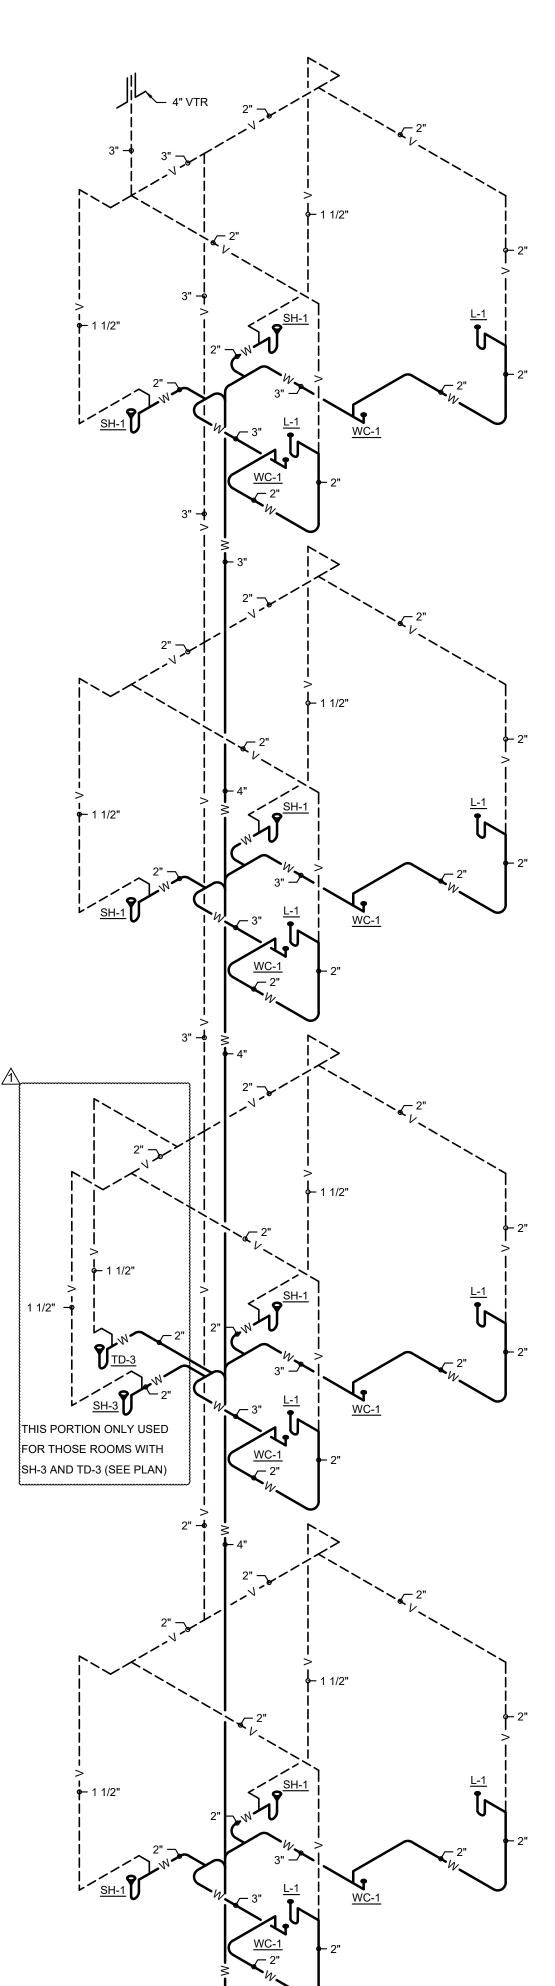

FIXTURE	ТҮРЕ	MANUFACTURER	MODEL NO.	TRIM	SUPPLIES	WASTE
SYMBOL		MANOFACTORER	MODEL NO.		SUFFLIES	WASTE
WC-1	WATER CLOSET	KOHLER	K-3505		BRASSCRAFT KTCR19 STOP	
	FLOOR MOUNT		1.6 GPM		SI-12 SUPPLY TUBES	
	FLUSH TANK		FLUSH		649 CHROME ESCUTCHEON	
NC-2	WATER CLOSET	KOHLER	K-3493 1.6 GPM		BRASSCRAFT KTCR19 STOP	
	FLUSH TANK - ADA		FLUSH		649 CHROME ESCUTCHEON	
NC-3	WATER CLOSET	KOHLER	K-3505		BRASSCRAFT KTCR19 STOP	
	FLOOR MOUNT FLUSH TANK		1.6 GPM FLUSH		SI-12 SUPPLY TUBES 649 CHROME ESCUTCHEON	
NC-4	WATER CLOSET	KOHLER	K-3493		BRASSCRAFT KTCR19 STOP	
	FLOOR MOUNT		1.6 GPM		SI-12 SUPPLY TUBES	
	FLUSH TANK - ADA		FLUSH		649 CHROME ESCUTCHEON	
JR-1	URINAL - ADA	KOHLER	K-4991	K-10949 FLUSH VALVE		
			.125 GPM			
			FLUSH			
1		KOHLER	K-2196-4	K-15583 FAUCET	BRASSCRAFT KTCR19 STOPS	POP UP WASTE ASSEMBLY
	DROP IN CHINA				SI-20 SUPPLY TUBES 649 CHROME ESCUTCHEONS	17 GA. CHROME P-TRAP ASSE W/BOX ESCUTCHEON
2	LAVATORY	KOHLER	K-2196-4	K-15583 FAUCET	BRASSCRAFT KTCR19 STOPS	POP UP WASTE ASSEMBLY
	DROP IN CHINA - ADA				SI-20 SUPPLY TUBES	17 GA. CHROME P-TRAP ASSE
					649 CHROME ESCUTCHEONS	W/BOX ESCUTCHEON
3	LAVATORY	KOHLER	K-2196-4	K-15583 FAUCET	BRASSCRAFT KTCR19 STOPS	GRID WASTE ASSMBLY
	DROP IN CHINA - ADA				SI-20 SUPPLY TUBES 649 CHROME ESCUTCHEONS	17 GA. CHROME P-TRAP ASSE W/BOX ESCUTCHEON
4	LAVATORY	KOHLER	K-12643	K-15583 FAUCET	BRASSCRAFT KTCR19 STOPS	GRID WASTE ASSMBLY
	WALL HUNG - ADA				SI-20 SUPPLY TUBES	17 GA. CHROME P-TRAP ASSE
					649 CHROME ESCUTCHEONS	W/BOX ESCUTCHEON
SK-1	SINK - STAINLESS	ADVANCE	T9-3-54-18RL	K-119 FAUCET	1/2" FULL PORT BALL VALVE	(3) STAINERS
	STEEL, THREE COMPARTMENT	TABCO			649 CHROME ESCUTCHEONS	PVC CONTINUOUS WASTE AS PIPED TO FSK W/ AIR GAP
 SK-2	NOT USED		<u> </u>			
 SK-3	SINK - STAINLESS	ADVANCE	7-PS-54		BRASSCRAFT KTCR19 STOPS	(1) CUP STYLE BASKET STRAI
	STEEL, WALL HUNG	ТАВСО			SI-20 SUPPLY TUBES	17 GA. CHROME P-TRAP ASSE
	HAND SINK				649 CHROME ESCUTCHEONS	W/BOX ESCUTCHEON
SK-4	SINK - STAINLESS STEEL, SINGLE	ADVANCE TABCO	DI-1-168	K-52 FAUCET	BRASSCRAFT KTCR19 STOPS SI-20 SUPPLY TUBES	(1) CUP STYLE BASKET STRAI 17 GA. CHROME P-TRAP ASSE
	COMPARTMENT				649 CHROME ESCUTCHEONS	W/BOX ESCUTCHEON
6H-1	SHOWER	COMFORT	SSS-6096 SH	K-304K VALVE		GLUE TYPE PVC SHOWER DR
		DESIGN		K-T6910-4A TRIM KIT		
		60" X 35" X 73"				
SH-2 SH-3	NOT USED SHOWER - ADA	COMFORT	SSS-6237 BF	K-304K VALVE		GLUE TYPE PVC SHOWER DR
511-0	SHOWER - ABA	DESIGN	000-0207 Di	K-T6910-4A TRIM KIT		
		62" X 37" X 78"				
EWC-1	ELECTRIC WATER	ELKAY	LNTE8K		BRASSCRAFT KTCR19 STOP	17 GA. CHROME P-TRAP ASSE
	COOLER - DUAL		LINILOR		SI-20 SUPPLY TUBE	W/BOX ESCUTCHEON
	HEIGHT - ADA				649 CHROME ESCUTCHEON	
EWC-2	ELECTRIC WATER	ELKAY	LZS7WSSK		BRASSCRAFT KTCR19 STOP	17 GA. CHROME P-TRAP ASSE
	COOLER - BOTTLE STATION - ADA				SI-20 SUPPLY TUBE 649 CHROME ESCUTCHEON	W/BOX ESCUTCHEON
MSK-1	MOP SINK	MUSTEE	63M	63.600A MOP SINK		STAINLESS STEEL GRID DRAI
				FAUCET WITH INTEGRAL		
				VACUUM BREAKER		
JB-1	WASHER BOX	GUY GRAY	SSWB-3			
ſMV	THERMOSTATIC	LAWLER	MODEL 805			
-D-1	MIXING VALVE FLOOR DRAIN	SIOUX CHIEF	832 SERIES	NICKEL BRONZE GRATE		
-D-1 -D-2	FLOOR DRAIN	SIOUX CHIEF	860 SERIES	CAST IRON GRATE		
SK	FLOOR SINK	SIOUX CHIEF	861 SERIES	NICKEL BRONZE GRATE		
[D-1	TRENCH DRAIN	ZURN	Z-893-12-72			
<sup>-</sup> D-2  -D-3	TRENCH DRAIN	ZURN SCHLUTER	Z-880-SOG KERDI-LINE			
	FLOOR CLEANOUT	SIOUX CHIEF	834 SERIES	 NICKEL BRONZE COVER	 	
HB	HOSE BIBB	WOODFORD	24			
NH	WALL HYDRANT	WOODFORD	65			
	DRAIN BOX	GUY GRAY	81957			
ЪВ	1	BRADLEY	S19-220B			
	EMERGENCY EYE	BIGGEL				
DB EEW-1	EMERGENCY EYE WASH					
		SPEAKMAN	SE-4000 GRAVITYFLO			


2. FIXTURES SHALL BE INSTALLED AS RECOMMENDED BY MANUFACTURER, INCLUDING MORTOR BEDS FOR SHOWERS AND BATHBAYS IF RECOMMENDED. 3. COORDINATE FLOORING/THRESHOLD HEIGHT REQUIREMENTS FOR ADA SHOWERS WITH GENERAL CONTRACTOR PRIOR TO ORDERING/ASSOCIATED WORK.

4. SHOWER DRAINS (IF APPLICABLE) SHALL BE INSTALLED WITH 100% SILICONE. COMPRESSION STYLE SHOWER DRAIN ASSEMBLIES ARE NOT ACCEPTABLE FOR T 5. TUB DRAIN ASSEMBLIES (IF APPLICABLE) SHALL BE FLEXIBLE GLUE TYPE. (WATCO FLEX 900 OR EQUAL) SLIP JOINT TUB DRAIN ASSEMBLIES ARE NOT ACCEPTABLE 6. THE FIXTURE STOPS AND SUPPLIES LISTED ABOVE SHALL BE CHROME 1/4 TURN BALL STYLE STOPS WITH CHROME METAL ESCUTCHEON TRIM RINGS (CAULKED TO WALL) AND FLEXIBLE BRAIDED STAINLESS STEEL SUPPLY TUBES.

	REMARKS		
	KOHLER K-4713 TOILET SEAT - EB, CLOSED FRONT WATER CLOSET FLANGES SHALL BE STAINLESS STEEL		
	COORDINATE FLANGE HEIGHT W/FLOORING KOHLER K-4713 TOILET SEAT - EB, CLOSET FRONT		
	TRIP LEVER TO WIDE SIDE OF STALL WATER CLOSET FLANGES SHALL BE STAINLESS STEEL		
	COORDINATE FLANGE HEIGHT W/FLOORING		
	KOHLER K-4666-SC-0 TOILET SEAT - EB, OPEN FRONT WATER CLOSET FLANGES SHALL BE STAINLESS STEEL COORDINATE FLANGE HEIGHT W/FLOORING		
	KOHLER K-4666-SC-0 TOILET SEAT - EB, OPEN FRONT		
	TRIP LEVER TO WIDE SIDE OF STALL WATER CLOSET FLANGES SHALL BE STAINLESS STEEL COORDINATE FLANGE HEIGHT W/FLOORING MOUNT TOP OF RIM 17" A.F.F. FOR ADA COMPLIANCE		
EMBLY			
EMBLY	TRUBRO TRAP AND SUPPLY TUBE COVERS		
EMBLY	TRUBRO TRAP AND SUPPLY TUBE COVERS		
EMBLY	TRUBRO TRAP AND SUPPLY TUBE COVERS		
SSY		A	
INER EMBLY			NOT DISCLOSED
NINER EMBLY			
RAIN	CAULK ALL FAUCET TRIM WITH 100% SILICONE. INSTALL PER MANUFACTURERS RECOMMENDATIONS. SECURE SHOWER HEAD ELBOW TO BACKING	Â	
RAIN	CAULK ALL FAUCET TRIM WITH 100% SILICONE. INSTALL PER MANUFACTURERS RECOMMENDATIONS. SECURE SHOWER HEAD ELBOW TO BACKING. FULL WOOD BACKING. U-SHAPED GRAB BAR.		
EMBLY	FOLD DOWN SEAT		
EMBLY			
IN	HOSE AND HOSE HOLDER MOP HANGER BRACKET		
	1/4 TURN VALVES INTEGRAL HAMMER ARRESTORS STAINLESS STEEL BOX		
	FINISH LINE SERIES FAT MAX SERIES		
	3/4 GRATE		
	STAINLESS STEEL 12" WIDE X 72" LONG DECORATIVE STAINLESS STEEL GRATE	$\wedge$	
	STAINLESS STEEL BODY AND DECORATIVE GRATE FINISH LINE SERIES	}	
	INTEGRAL VACUUM BREAKER		
	INTEGRAL VACUUM BREAKER LESS VALVES, VALVE HOLES ALREADY PUNCHED OUT		
	PROVIDE WITH THERMOSTATIC MIXING VALVE SIMILAR TO \$19-2000		
	21 GALLON PORTABLE EYEWASH		
THIS PROJEC			PLUMBING

# RISERS



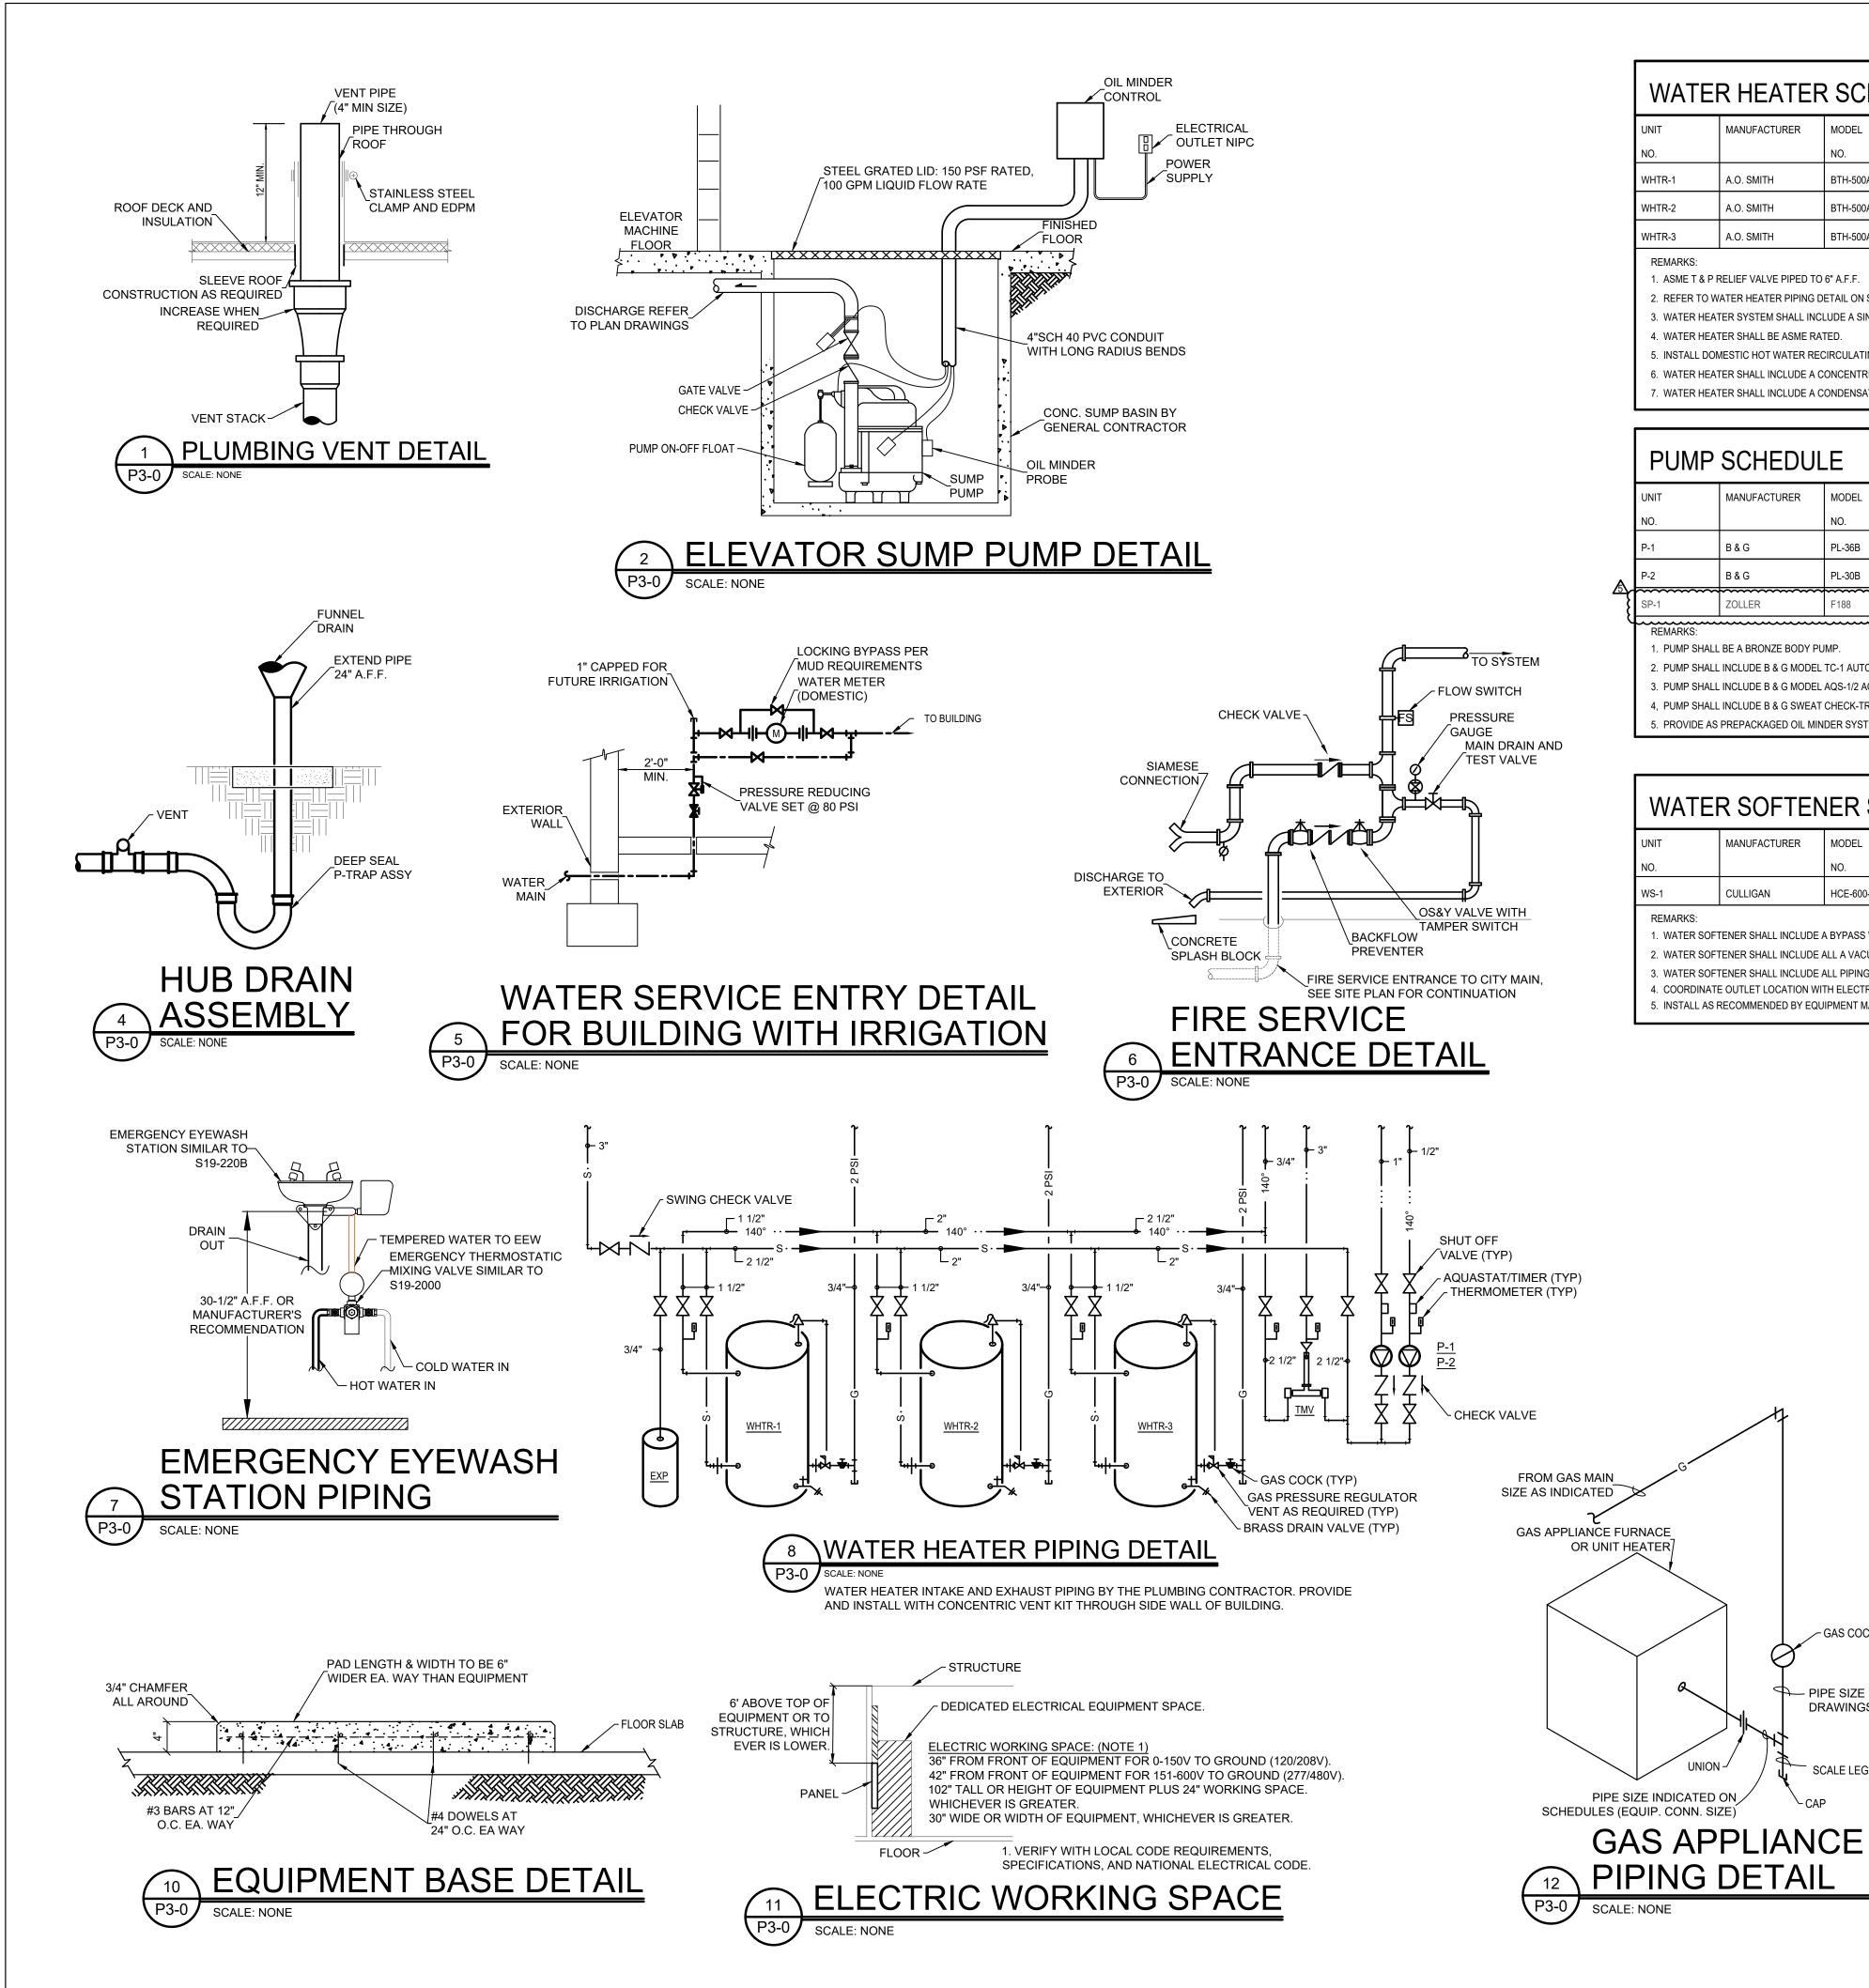

WATER HEATER SCHEDULE											
UNIT	MANUFACTURER	MODEL	CAPACITY	RECOVERY @ 90°	INPUT	THERMAL	ELECTRICAL		SHIPPPING	OPERATING	REMARKS
NO.		NO.	GALLONS	GPH	(MBH)	EFFICIENCY	V/PH	FLA	WEIGHT (LBS)	WEIGHT (LBS)	
WHTR-1	A.O. SMITH	BTH-500A (ASME RATED)	119	640	499.9	95%	120/1	5.0	855	1807	1, 2, 3, 4, 5, 6, 7
WHTR-2	A.O. SMITH	BTH-500A (ASME RATED)	119	640	499.9	95%	120/1	5.0	855	1807	1, 2, 3, 4, 5, 6, 7
WHTR-3	A.O. SMITH	BTH-500A (ASME RATED)	119	640	499.9	95%	120/1	5.0	855	1807	1, 2, 3, 4, 5, 6, 7
REMARKS:											

1. ASME T & P RELIEF VALVE PIPED TO 6" A.F.F.

2. REFER TO WATER HEATER PIPING DETAIL ON SHEET P-1.

3. WATER HEATER SYSTEM SHALL INCLUDE A SINGLE AMTROL ST-30V-C ASME RATED FREE STANDING THERMAL EXPANSION TANK.

4. WATER HEATER SHALL BE ASME RATED.

5. INSTALL DOMESTIC HOT WATER RECIRCULATING PUMP. SEE PUMP SCHEDULE ON THIS SHEET 6. WATER HEATER SHALL INCLUDE A CONCENTRIC INTAKE/EXHAUST VENT KIT.

7. WATER HEATER SHALL INCLUDE A CONDENSATE NEUTRALIZATION KIT. ROUTE PIPING TO FLOOR DRAIN.

## 

	PUMP SCHEDULE												
	UNIT	MANUFACTURER	MODEL	DESCRIPTION	STYLE	SIZE	GPM	HEAD	MOTOR		ELECTRICAL		REMARKS
	NO.		NO.					(FT)	HP	RPM	VOLTS/PH	F.L.AMPS	
	P-1	B & G	PL-36B	DOMESTIC HW RECIRC	INLINE	1"	10	30	1/6	3300	115/1	2.1	1,2,3,4
A	P-2	B&G	PL-30B	140° DOMESTIC RHW	INLINE	3/4"	5	20	1/12	3300	115/1	2.1	1,2,3,4
<u> </u>	SP-1	ZOLLER	F188	ELEVATOR SUMP PUMP	SUMP	2"	100	40	1-1/2 HP	-	208/1	16.8	5
Q													

1. PUMP SHALL BE A BRONZE BODY PUMP.

PUMP SHALL INCLUDE B & G MODEL TC-1 AUTOMATIC TIMER KIT OR EQUAL

3. PUMP SHALL INCLUDE B & G MODEL AQS-1/2 AQUASTAT OR EQUAL.

4, PUMP SHALL INCLUDE B & G SWEAT CHECK-TROL FLANGES WITH INTEGRAL CHECK VAVLES.

5. PROVIDE AS PREPACKAGED OIL MINDER SYSTEM COMPLETE WITH PUMP, FLOAT AND ALARM PANEI

WATER SOFTENER SCHEDULE												
UNIT	MANUFACTURER	MODEL	DESCRIPTION	RESIN	CONT. FLOW	PEAK FLOW	DRAIN FLOW	OPEATING	SHIPPING	INLET SIZE	OUTLET SIZE	REMARKS
NO.		NO.		VOLUME	(GPM)	(GPM)	(GPM)	WEIGHT	WEIGHT			
WS-1	CULLIGAN	HCE-600-3	DUPLEX SOFTENER ASSY	20 FT <sup>3</sup>	185	250	30	8571	3861	3"	3"	1,2,3,4
REMARKS: 1. WATER SOFTENER SHALL INCLUDE A BYPASS VALVE ASSEMBLY.												

2. WATER SOFTENER SHALL INCLUDE ALL A VACUUM RELIEF VALVE.

3. WATER SOFTENER SHALL INCLUDE ALL PIPING/DRAINS/DISCHARGE TO FLOOR DRAINS VIA AN INDIRECT WASTE CONNECTION.

4. COORDINATE OUTLET LOCATION WITH ELECTRICAL CONTRACTOR PRIOR TO ASSOCIATED WORK.

5. INSTALL AS RECOMMENDED BY EQUIPMENT MANUFACTURER.

- GAS COCK


- PIPE SIZE INDICATED ON

DRAWINGS (LINE SIZE)

SCALE LEG (LINE SIZE)

9 P3-0

REMOTE MOUNTED CONTROLS

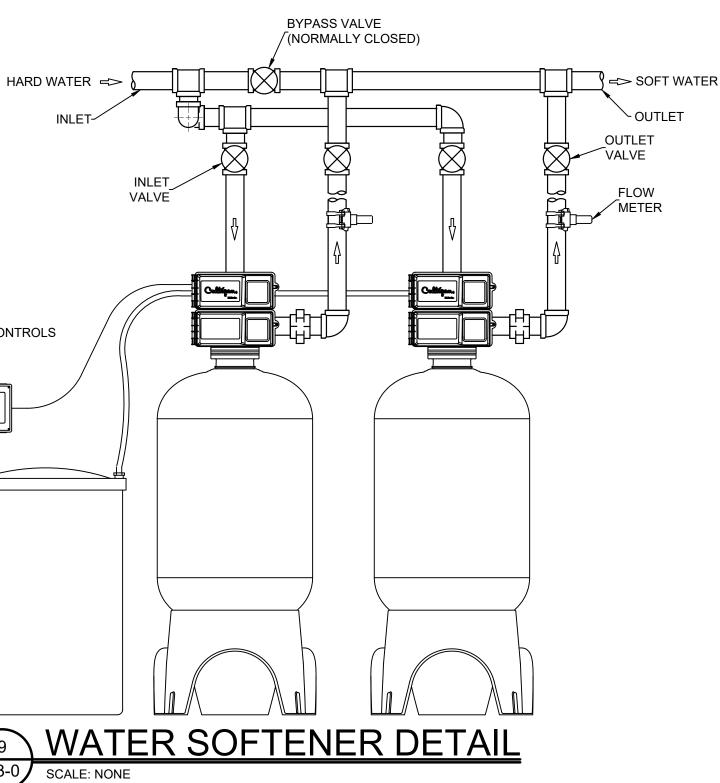




### PLUMBING SCHEDULE AND DETAILS


Sheet No. |


P3.0

<sup>o</sup>rinted On: 9/19/2016 8:54:10 AM

## 2 ENLARGED PLUMBING PLAN - PUBLIC RESTROOMS

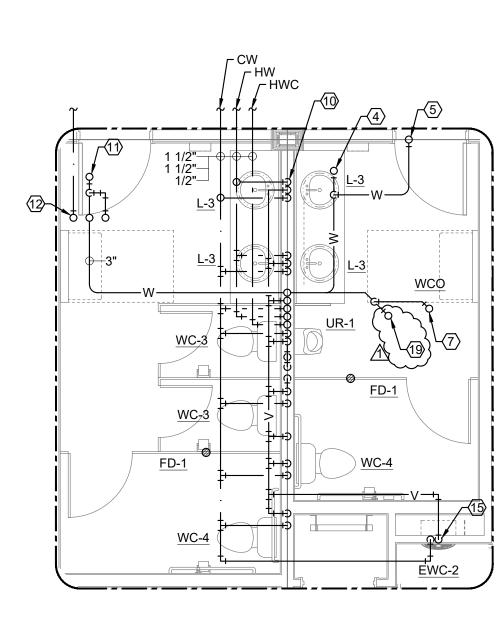

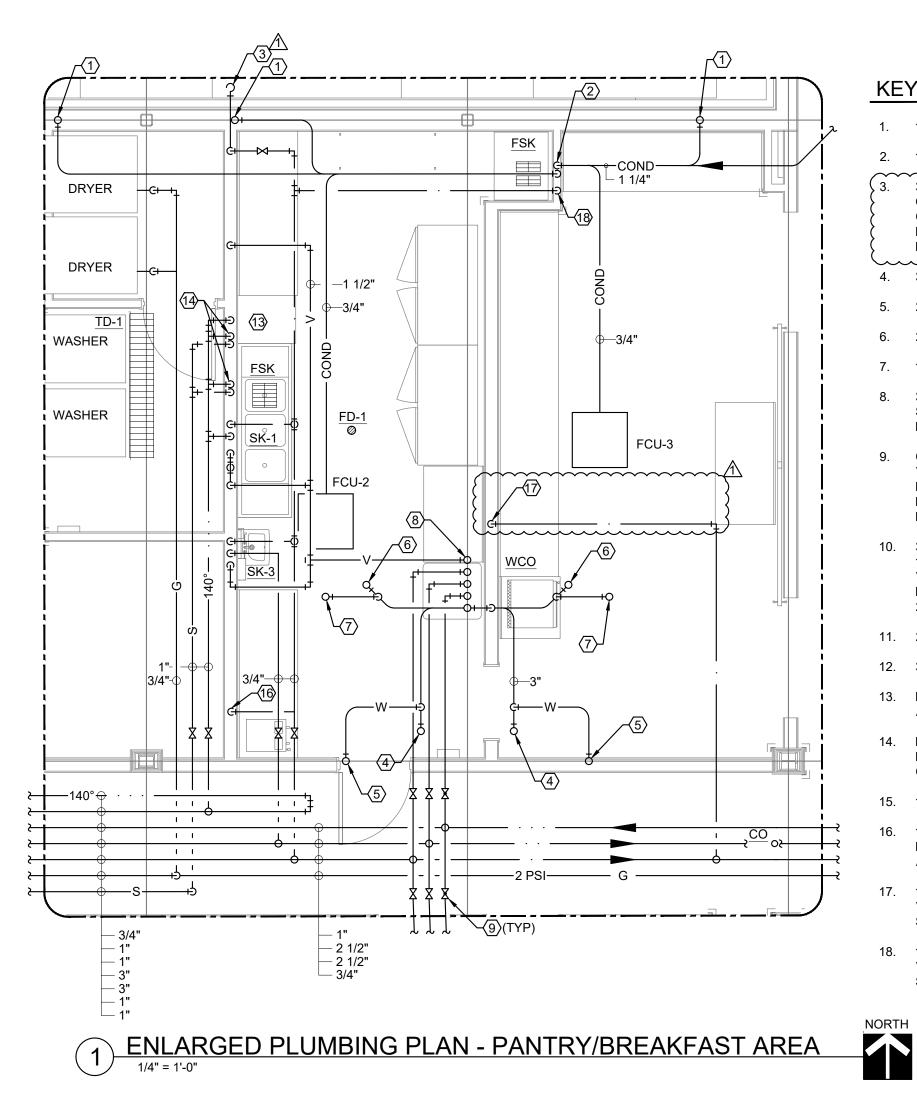

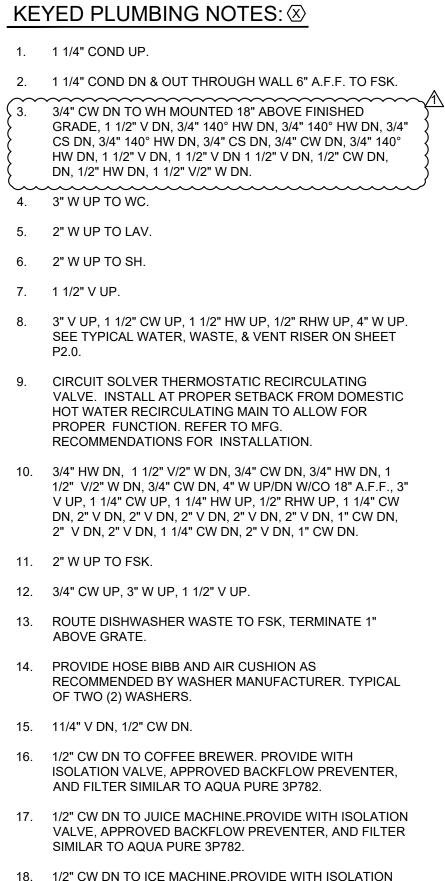


 1/2" CW DN TO ICE MACHINE.PROVIDE WITH ISOLATION VALVE, APPROVED BACKFLOW PREVENTER, AND FILTER SIMILAR TO AQUA PURE 3P782.



3624 Farnam Street

Tel | 402.342.5575

Omaha, Nebraska 68131

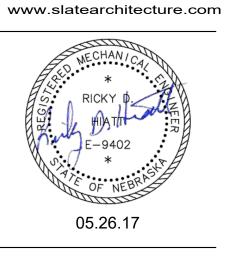

HOLIDAY INN EXPRESS & SUITE 2431 FARNAM STREET OMAHA, NEBRASKA 68102

S

Revisions | 1 08.25.2017 5 03.19.2018 6 03.27.2018

Project No. | 16030 Issue Date | 05.26.2017

ENLARGED PLUMBING PLANS



NORTH



